


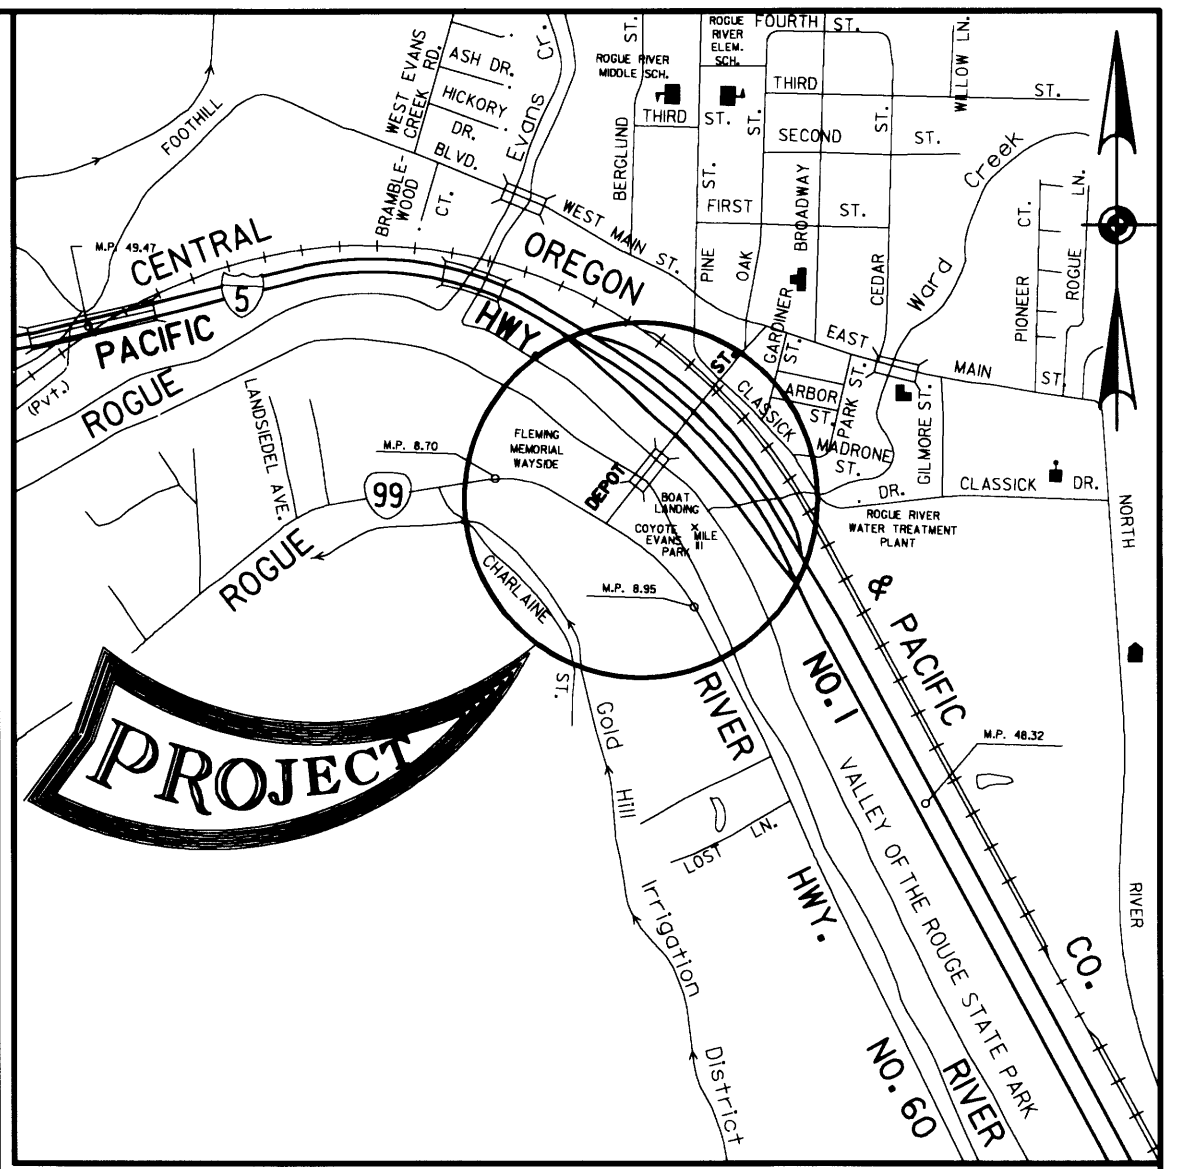

SEC. 21, T. 36 S., R. 4 W., W.M.
LOCATION MAP

No Scale

<i>HYDRAULIC DATA</i>		
	<i>DESIGN BASE FLOOD</i>	<i>MAXIMUM PROBABLE FLOOD</i>
<i>DISCHARGE (cms)</i>	<i>3402.7</i>	<i>5735.3</i>
<i>FREQUENCY (yrs)</i>	<i>100</i>	<i>500</i>
<i>H.W.ELEVATION AT UPSTREAM FACE OF BRIDGE</i>	<i>305.81</i>	<i>308.42</i>
<i>BACKWATER (m)</i>	<i>0.17</i>	<i>0.14</i>

Note:
See Dwg #61720 for General Notes.

Note:
Elevations shown are based
on the National Geodetic
Vertical Datum (M.S.L. = 0.0).

ACCOMPANIED BY DWGS.
RD333, RD336, RD364, RD500 & TM409

Co. Br. No. 06970

Note:
All dimensions are in millimeters (mm) and
all elevations are meters (m) except as noted.

	DATE	REVISION	BY	A. Mitchell	DESIGNER	BRIDGE ENGINEER	 OREGON DEPARTMENT OF TRANSPORTATION BRIDGE ENGINEERING SECTION	BRIDGE NO. 19273	ROGUE RIVER (DEPOT STREET) BRIDGE ROGUE RIVER BRIDGE SECTION JACKSON COUNTY			SHEET 1 OF 81
	03/08	AS CONSTRUCTED	AVS	DRAFTED:		 REVIEWED:		DATE Nov. 2002				PLAN AND ELEVATION
				CHECKED:  Kent Cordtz				CALC. BOOK 5081				
				REVIEWED:  Terry Shike				EXPIRES: 12-31-04	ACCOMPANIED BY DWGS. 61720-61799, BR135, 136, 140, 141 BR145, 165, 200, 203, 206, 216, 233, 273, 286, 966 & 970			



GENERAL NOTES:

Provide all materials and perform all work according to the 1996 Standard Specifications for Highway Construction and the 1998 Supplemental Standard Specifications of the Oregon Department of Transportation.

Bridge is designed for HL-93 loading with an allowance of 1.2 kN/m2 for future wearing surface.

Concrete members are designed by the Load and Resistance Factor Design Method of AASHTO LRFD Bridge Design Specification, Second Edition, as ammended.

Bridge Hanger Cable Assemblies have been designed with a minimum factor of saftey of 4.0 vs. calculated maximum service loads.

Seismic design is by single-mode analysis in accordance with the AASHTO Division I-A, Seismic Design of the "Standard Specifications for Highway Bridges". 16th Edition, as ammended. The site peak bedrock acceleration coefficient (A) is 0.23 (500 Yr) and the assumed site coefficient (S) is 1.0. The response modification factors are: R=5.0 for column moment, R=0.8 for abutments and R=1.0 for other components.

Spiral column reinforcement shall conform to ASTM specification A706, AASHTO specification M31 (ASTM A615M) grade 420, AASHTO M226M (ASTM A496), or AASHTO M32M (ASTM A82).

Provide all reinforcing steel according to ASTM Specification A706M or AASHTO M31M (ASTM A615M) Grade 420. Provide field bent bars according to ASTM Specification A706M. Use the following splice lengths unless shown otherwise:

Reinforcing Splice Lengths (Class B) Grade 420 (mm)											
Bar Size	#10	#13	#16	#19	#22	#25	#29	#32	#36	#43	#57
Uncoated	300	325	425	600	825	1075	1350	1700	2100	Not Permitted	

Splice reinforcing steel at alternate bars, staggered at least one splice length or as far as possible, unless shown otherwise.

Do not fabricate reinforcing steel for columns and Bent walls until final footing elevations have been determined in the field.

Place bars 50 mm clear of the nearest face of concrete unless shown otherwise.

Provide prestressing steel according to the detail plans.

Provide Class 35-19 concrete in all superstructure elements including the arch ribs, Tie Girder, Span 1 Box Girder, Floor beams, Stringers, Span 2 End Slabs, and Bent 2 Cross Beam.

Provide Class 35-19 microsilica modified concrete for all decks.

Provide Class 25-10 (pea gravel) concrete, sutable for exposed aggregate finish in all sidewalks, Spans 1 & 2.

Concrete for reinforced concrete end panels in accordance w/ the detail plans.

All other concrete Class 25 - 38, 25 or 19.

Support bottom mat of reinforcing steel on precast mortar blocks @ 900 mm max. centers each way, support top mat from bottom mat with reinforcing bar supports by Dayton Superior Co. (SBU, BBU, or CHW) or approved equal @ 900 mm centers each way.


Fabricated steel to be hot dip galvanized, control silicon - according to specification 02530

All steel pipe to be ASTM A53 Grade B or ASTM A501, hand selected to ensure consistent and true inside diameter, test as req'd for fit of top cable anchor block.

Hanger Cable Assembly materials shall be in accordance with the detail plans.

Seismic restraint cables shall meet ASTM A603 w/ Class C galvanized coating.

Steel handrail to be finished according to specification 00587.

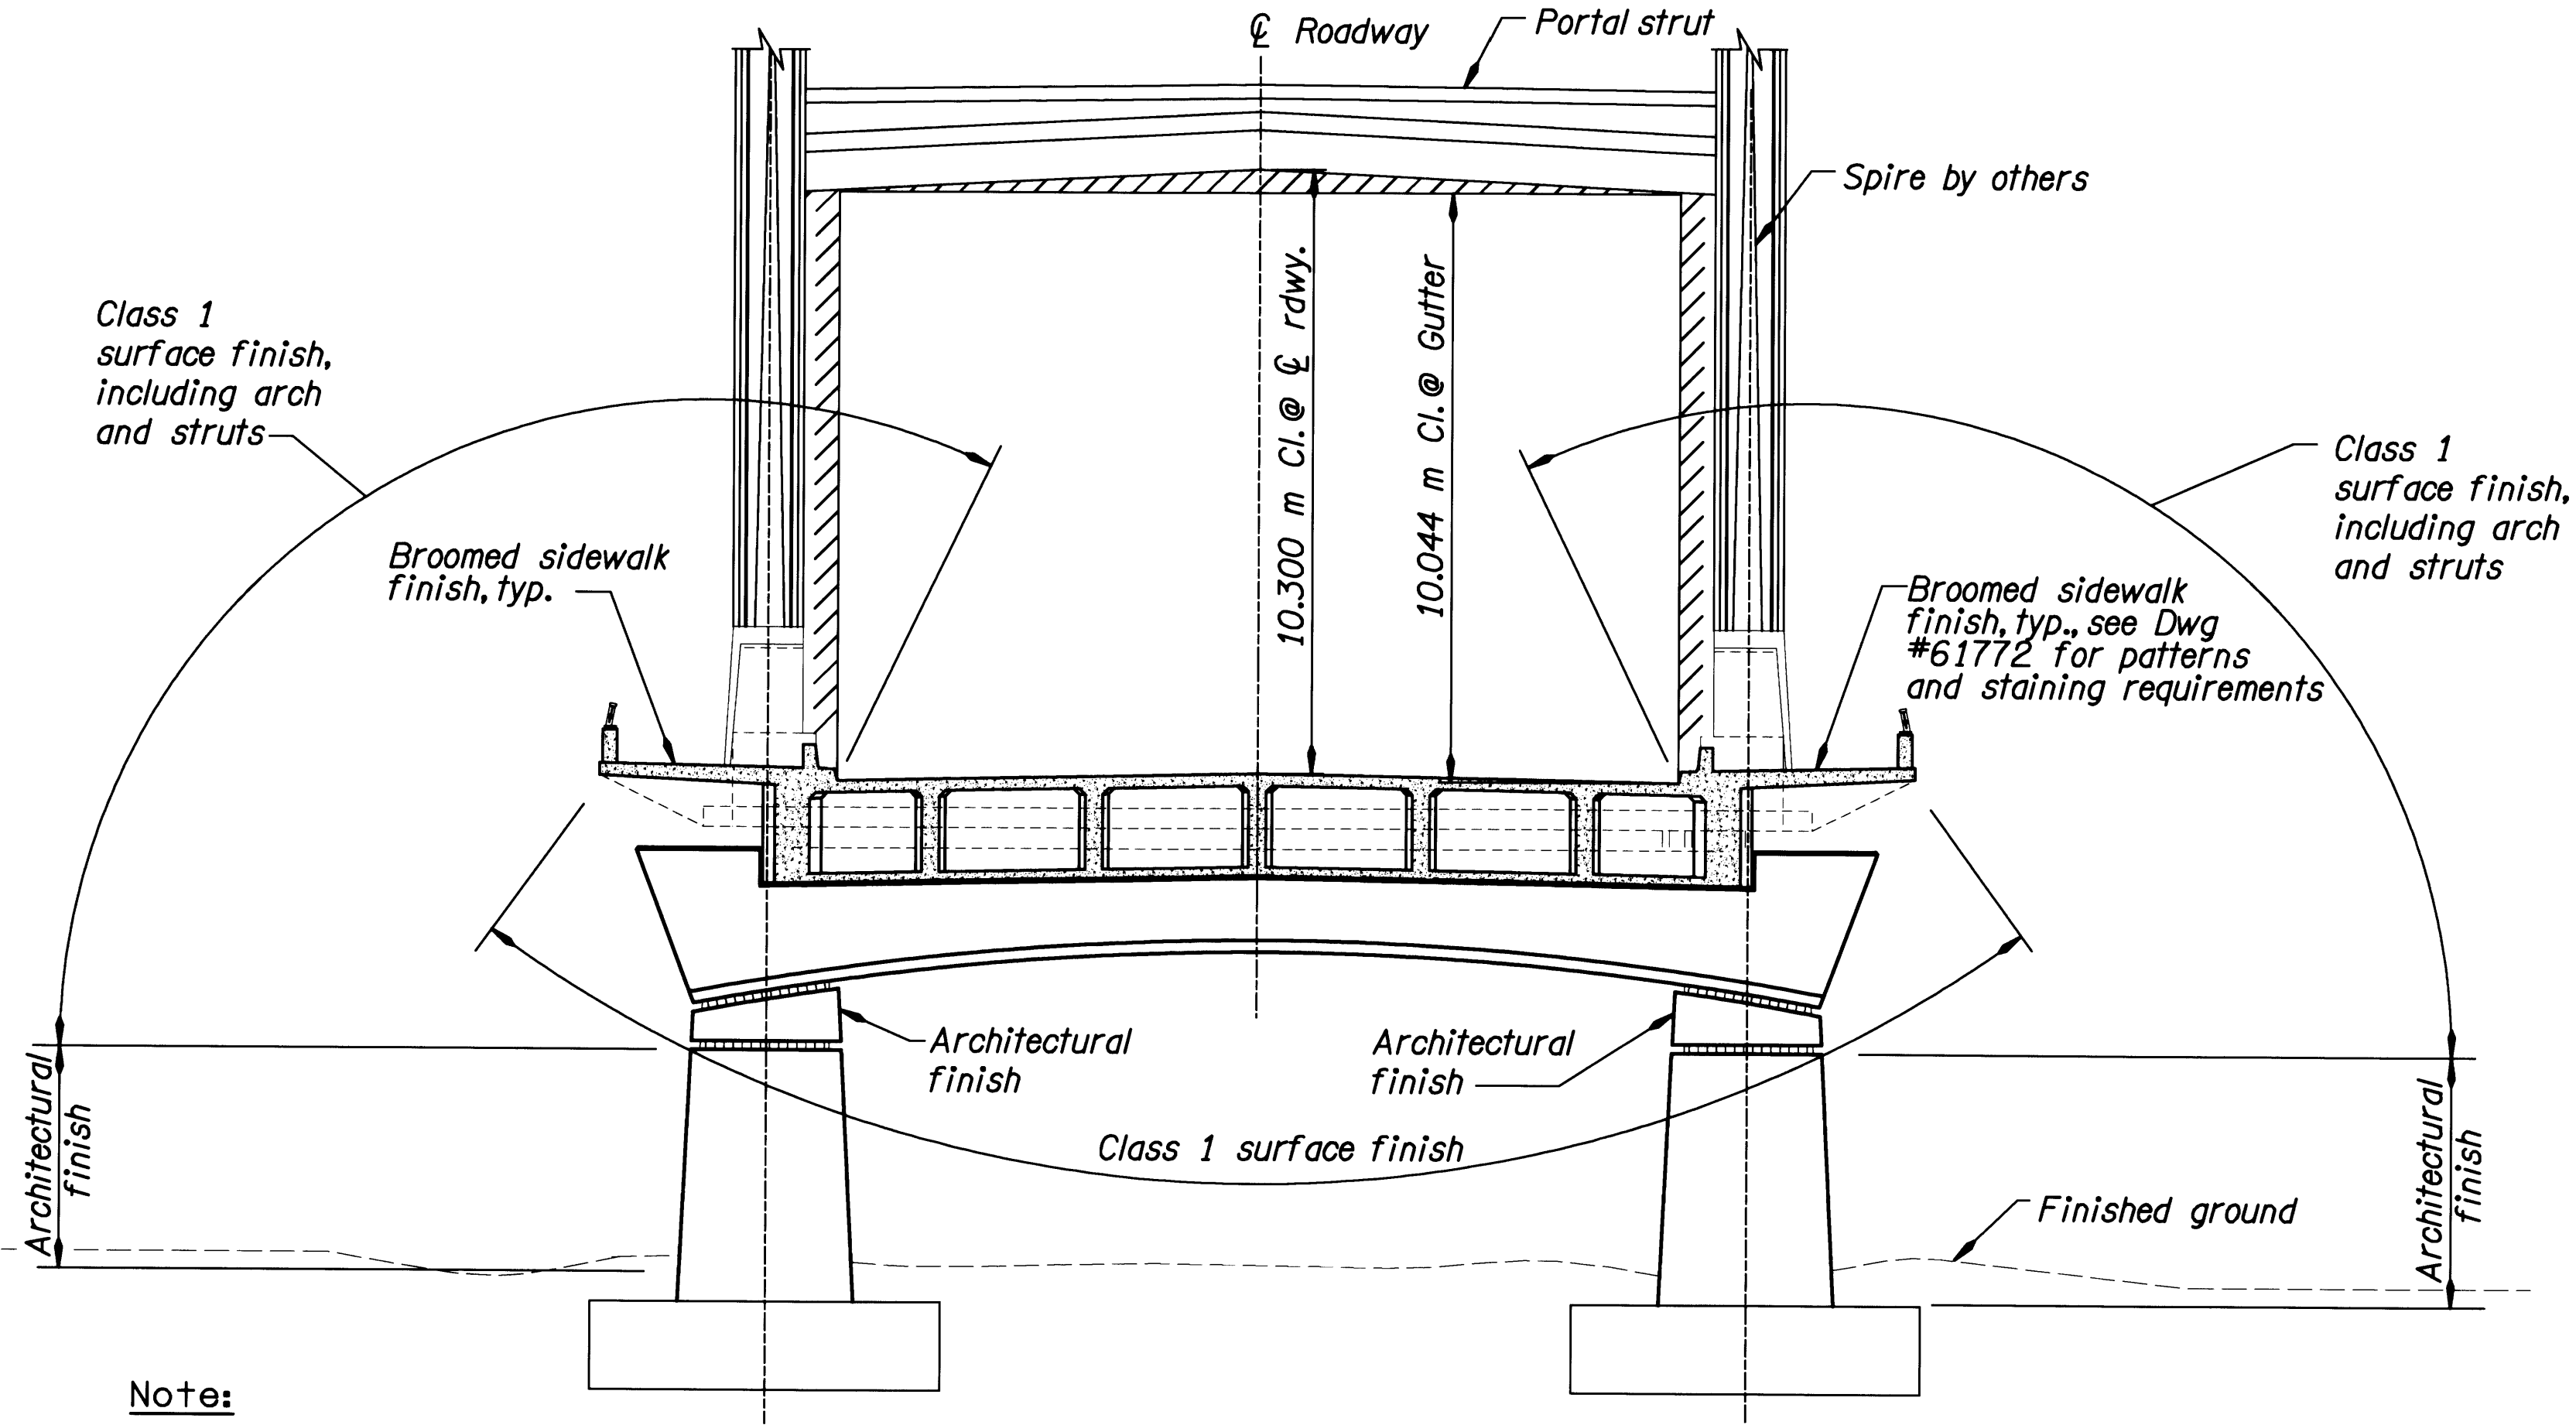

Note:
All other surfaces shall be finished as indicated in Special Provisions.

CONCRETE FINISH DETAIL
No Scale

CONSTRUCTION NOTES:

Span 2 support falsework

Longitudinal post-tensioning of tie girders will result in no uplift of the structure. Transverse post-tensioning of the deck system will result in unloading of deck falsework, transferring loads to the tie girder support system. Contractor to design falsework support under the tie girder to support all dead and construction live loads. Falsework shall not constrict shortening of the span in either direction due to application of post-tensioning. Falsework under the tie girders will be under significant load at time of removal.

All permanent piling to be HP360x174, AASHTO M270M, grade 345 (ASTM A572) w/ cast driving shoe driven to an ultimate capacity of 3000 kN per pile.

All temporary piling, in the horizontal jacking system footings, to be HP360x174, AASHTO M270M, grade 345 (ASTM A572) w/ cast driving shoe driven to an ultimate capacity of 3000 kN per pile.


All permanent piling to be prebored to the elevation shown. Minimum prebored hole diameter is 600 mm. Prebored holes filled after piles have been driven. See special provisions.

Pile tip for min. penetration shall be Elevation 290.0 for Bent 1, Elevation 285.5 for Bent 2 and Elevation 291.0 for Bent 3, and Elevation 290.5, Elevation 296.0 for temporary foundation piles at Bents 2 & 3, respectively.

All permanent piling to be driven to the ultimate capacity using criteria developed from a Wave equation analysis with a minimum hammer energy rating of 135 kJ.

Note:
All dimensions are in millimeters (mm) and all elevations are meters (m) except as noted.

A	DATE	REVISION	BY	J. Culpepper	DESIGNER	 DAVID EVANS AND ASSOCIATES INC. 530 Center Street N.E., Suite 605 Salem Oregon 97301 Phone: 503.361.8635	 OREGON DEPARTMENT OF TRANSPORTATION BRIDGE ENGINEERING SECTION	BRIDGE NO.	ROGUE RIVER (DEPOT STREET) BRIDGE	SHEET 2 OF 81		
	03/08	AS CONSTRUCTED	AVS	Checked: Kent Cordtz	REVIEWED: Terry Shike			DATE			Nov. 2002	DRAWING NO. 61720
								CALC. BOOK			5081	

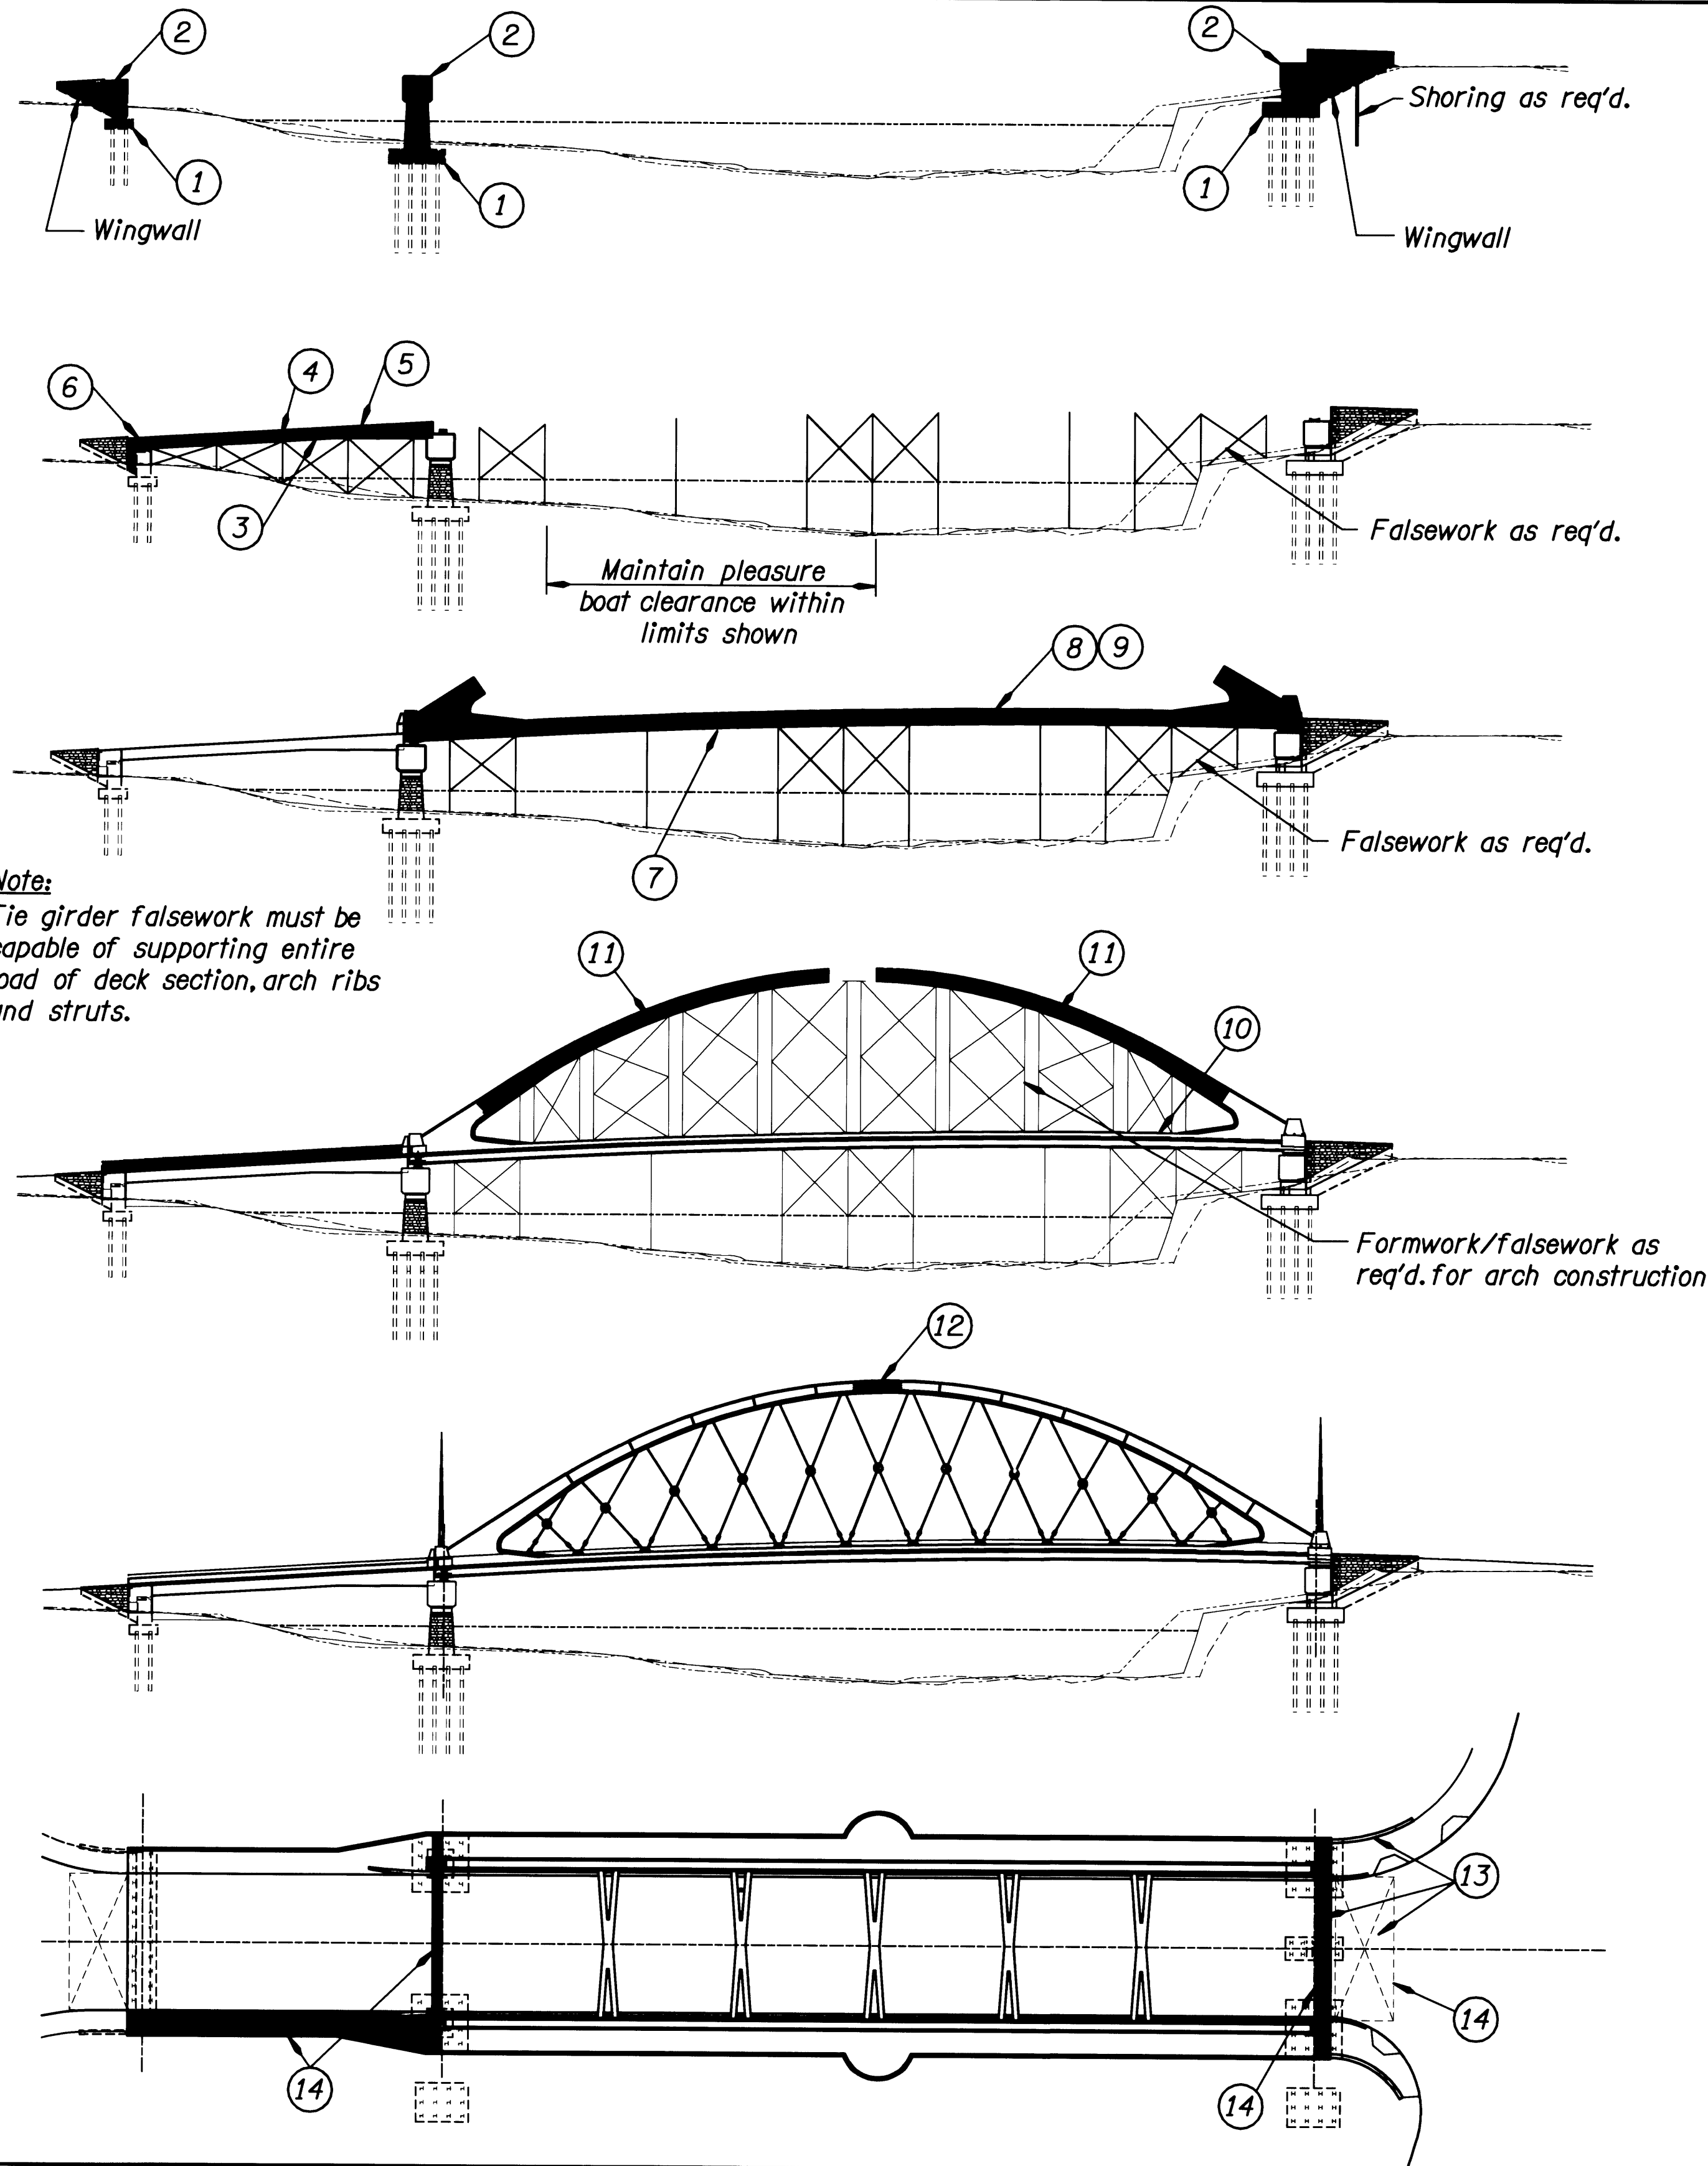

Note:
Tie girder falsework must be capable of supporting entire load of deck section, arch ribs and struts.

CONCRETE PLACEMENTS

- ① Pile Caps, All Bents
- ② Columns, Abutment Walls, Wingwalls and Bent X-Beams
-Post-Tension Bent 2 Cross beam
- ③ Span 1 Bottom slab
- ④ Span 1 Stems and End Beams
- ⑤ Span 1 Deck
-Post-Tension Span 1-
- ⑥ Install End Panel support/girder end block
@ Bent 1, sidewalks and Rails to extent
allowed by Stage II Traffic Alignment
- ⑦ Span 2 Tie Girders
- ⑧ Span 2 Floor beams and stringers
- ⑨ Span 2 Deck

To facilitate schedule the contractor may elect to make placements 7, 8 and 9 in portions. Placement sequence and joint location must be submitted to the Engineer for approval prior to beginning work. 3 Days minimum waiting period between placements will be required. Placements 8 & 9 may be combined (microsilica concrete req'd.)

Post-tensioning sequence

- Post-Tension Span 2 Solid Slab Regions, transverse-
- Post-Tension Tie Girders Longitudinal-
- Post-Tension Floor beams (may be completed-
prior to Tie Girder @ contractors option)

- ⑩ Install Type "F" Traffic Barrier, Span 2,
after longitudinal Post-Tensioning.
- ⑪ Arch Rib placement, cure 7 days min.
- ⑫ Arch Crown placement

Note:

Arch Crown placement to cure a minimum of 7 days and attain 28 day strength prior to hanger cable tensioning.

Install and Tension Hanger Strands
Release/Remove Falsework, Span 2,
see special provisions

Stage II Traffic

- ⑬ Complete Bent 3


Stage III Phase 1 Traffic

Move Span 2 into final position

Stage III Phase 2 Traffic


- ⑭ Complete Bent 3 End Panel, Span 1 sidewalk, and expansion joint seal installation and Span 1 pylon.

Sidewalks on Span 2 may be constructed at any time after application of Post-Tensioning on Span 2 Tie Girder and post-tensioning of floor beams.

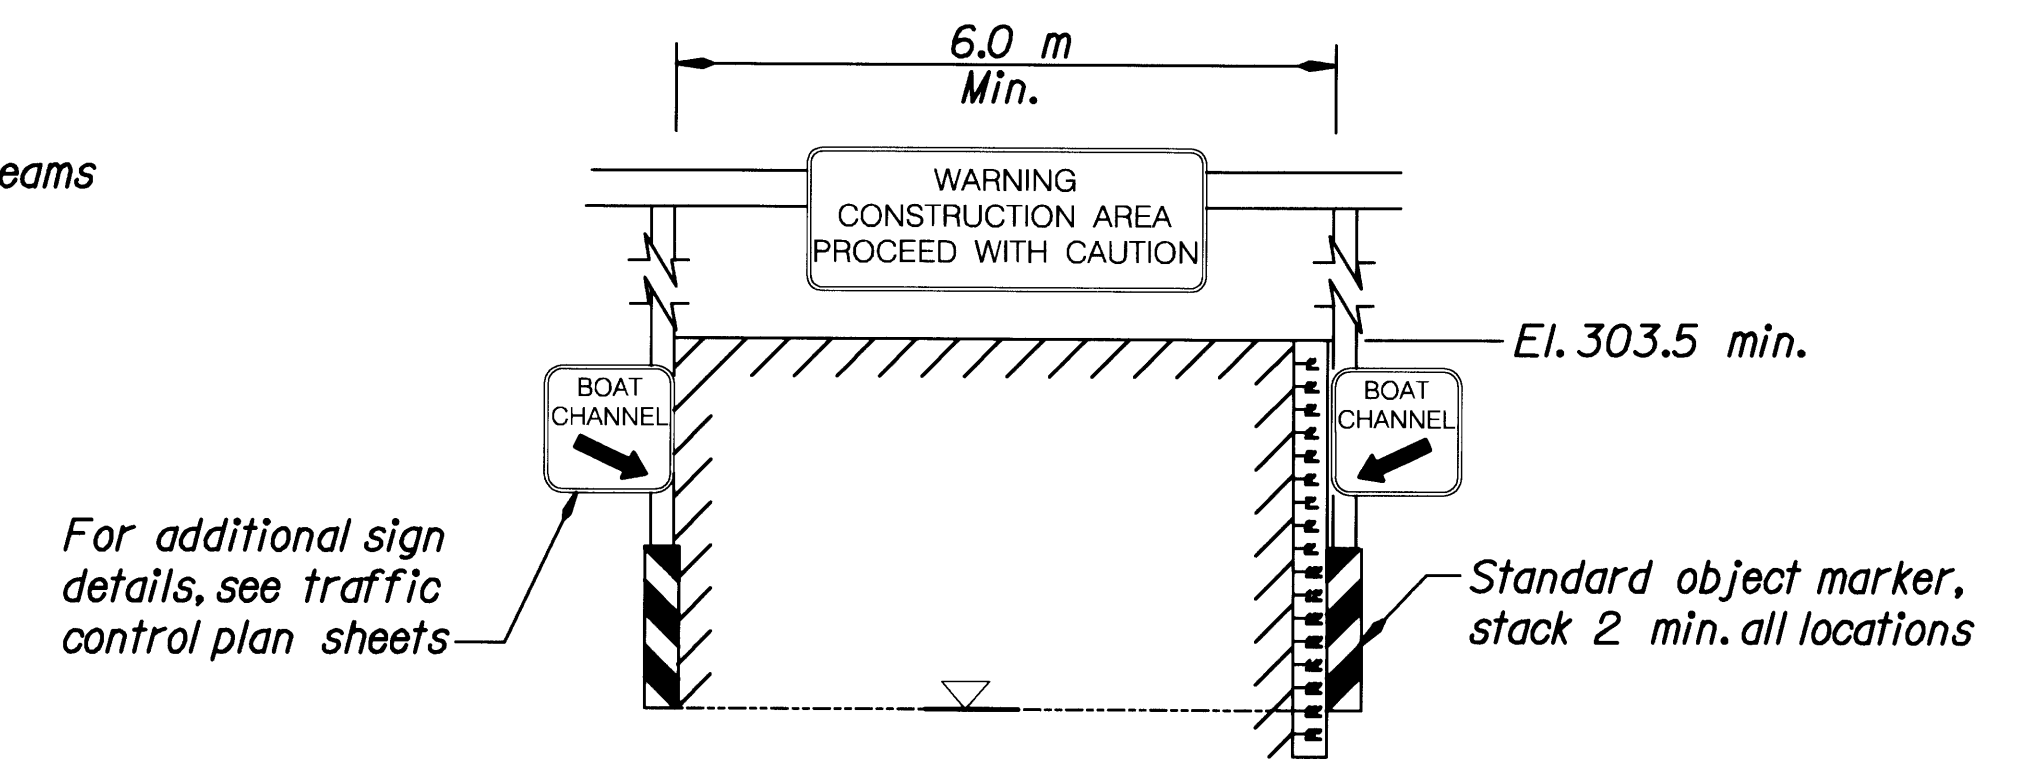

PLEASURE BOAT CLEARANCE DIAGRAM

Scale: 1:100

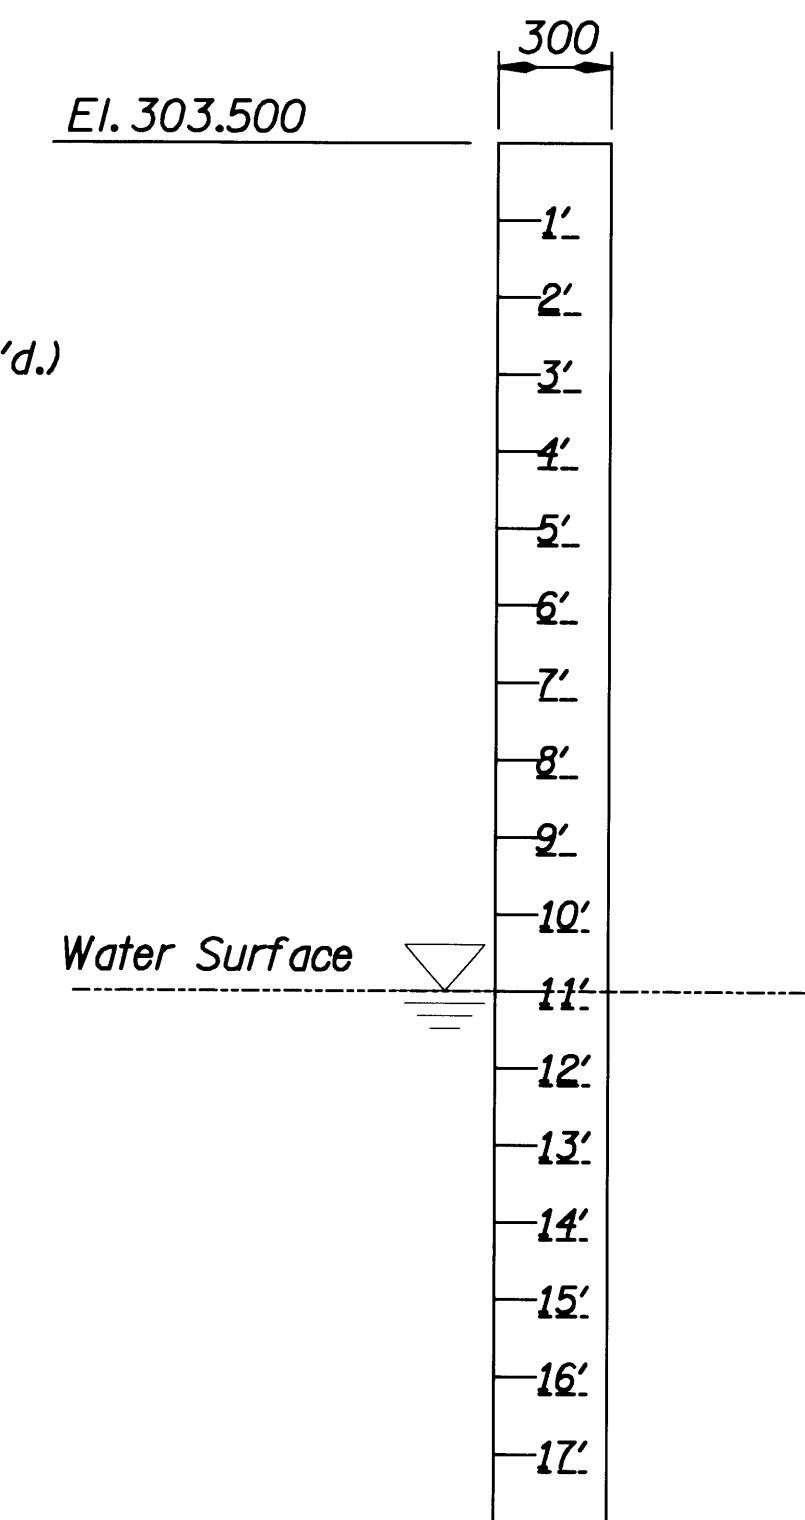

CLEARANCE INDICATOR

No Scale

CLEARANCE INDICATOR NOTES

Background color shall be white.


Lettering shall be min. of 100 mm in height and black in color.


Markings shall be at least one foot increments and black in color.



Contractor may paint "Clearance Indicator" and stripes directly on falsework, with approval from the Engineer.

Note:
All dimensions are in millimeters (mm) and all elevations are meters (m) except as noted.

DATE	REVISION	BY	DESIGNER	BRIDGE NO.	DATE	CALC. BOOK	DRAWING NO.
03/08	AS CONSTRUCTED	AVS	J. Culpepper DRAFTED: CHECKED: <i>Bent Cordtz</i> Terry Shike REVIEWED: <i>Terry Shike</i>	19273	Nov. 2002	5081	61724
DAVID EVANS AND ASSOCIATES INC. 530 Center Street N.E., Suite 605 Salem Oregon 97301 Phone: 503.361.8635				OREGON DEPARTMENT OF TRANSPORTATION BRIDGE ENGINEERING SECTION			
ROGUE RIVER (DEPOT STREET) BRIDGE				CONSTRUCTION SEQUENCE AND DETAILS			
SHEET 6 OF 81				METRIC			

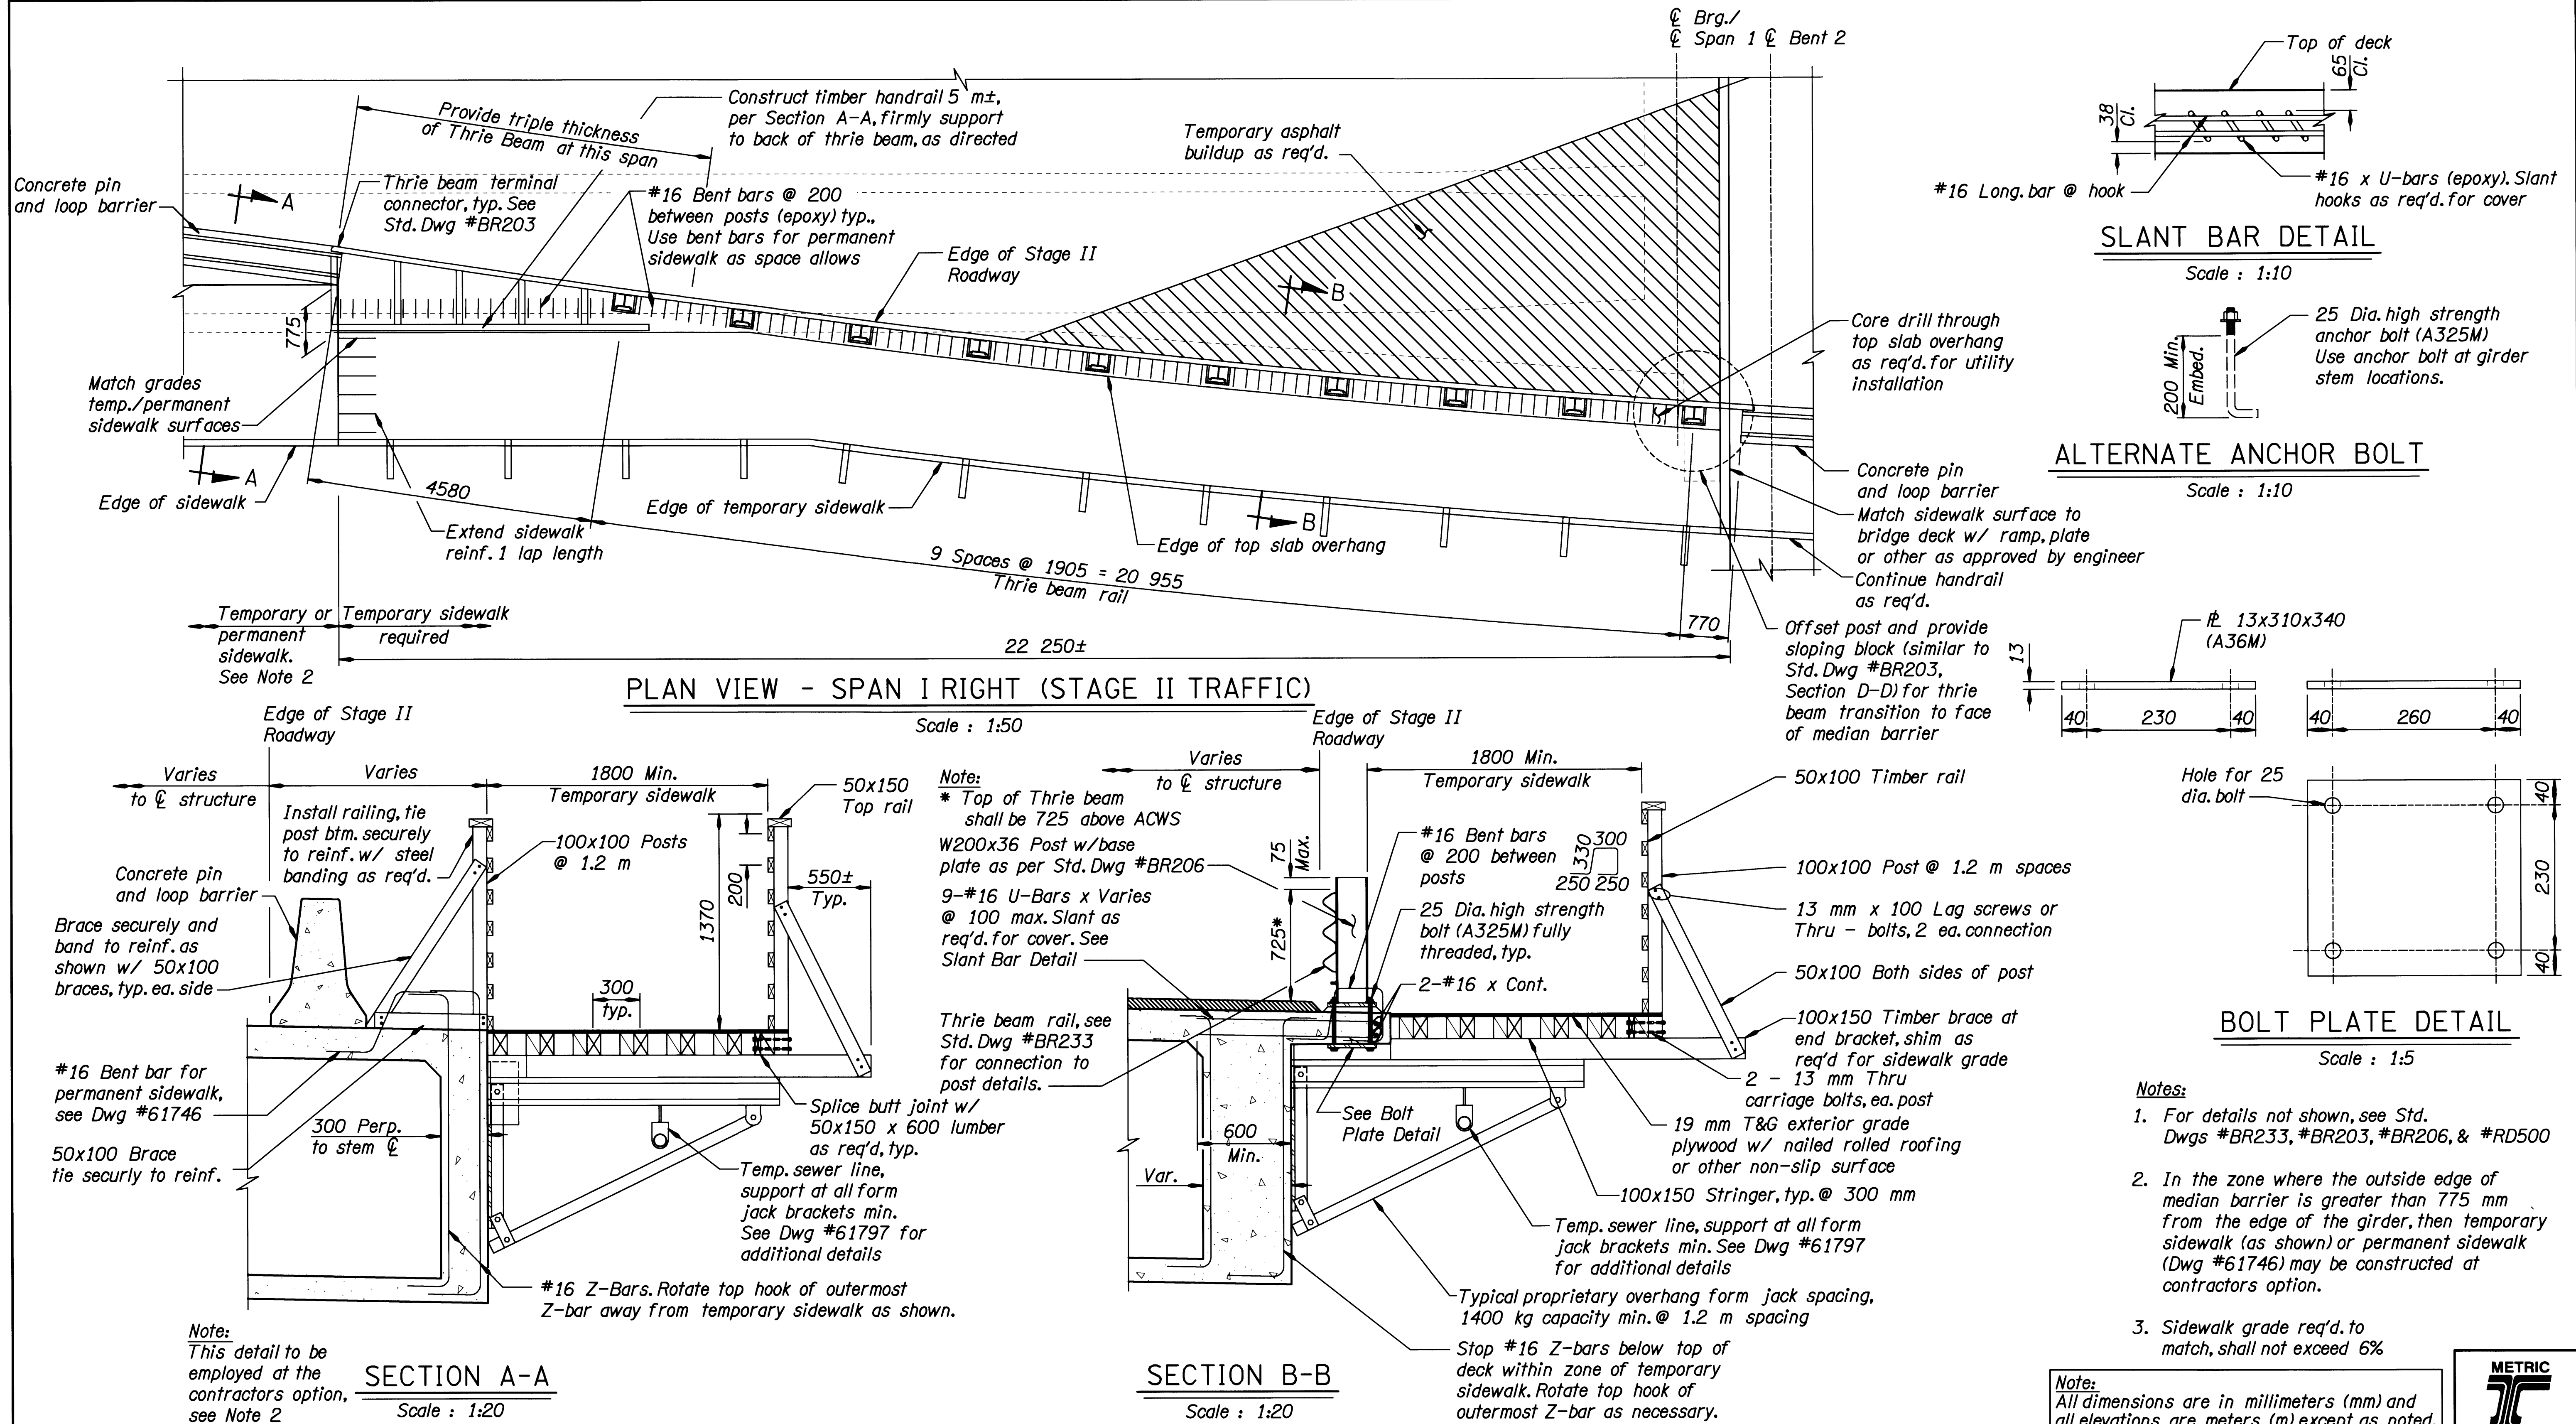


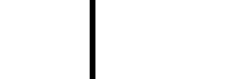
	DATE	REVISION	BY	<i>R. Elwood</i>	DESIGNER	 DAVID EVANS AND ASSOCIATES INC. 530 Center Street N.E., Suite 605 Salem Oregon 97301 Phone: 503.361.8635	 OREGON DEPARTMENT OF TRANSPORTATION BRIDGE ENGINEERING SECTION	BRIDGE NO. 19273	ROGUE RIVER (DEPOT STREET) BRIDGE	SHEET 7 OF 81
	03/08	AS CONSTRUCTED	AVS	DRAFTED:	CHECKED: <i>Kent Cordtz</i> Kent Cordtz			DATE Nov. 2002		DRAWING NO. 61725
					REVIEWED: <i>Terry Shike</i> Terry Shike			EXPIRES: 12-31-04	CALC. BOOK 5081	TEMPORARY TRAFFIC DETAILS

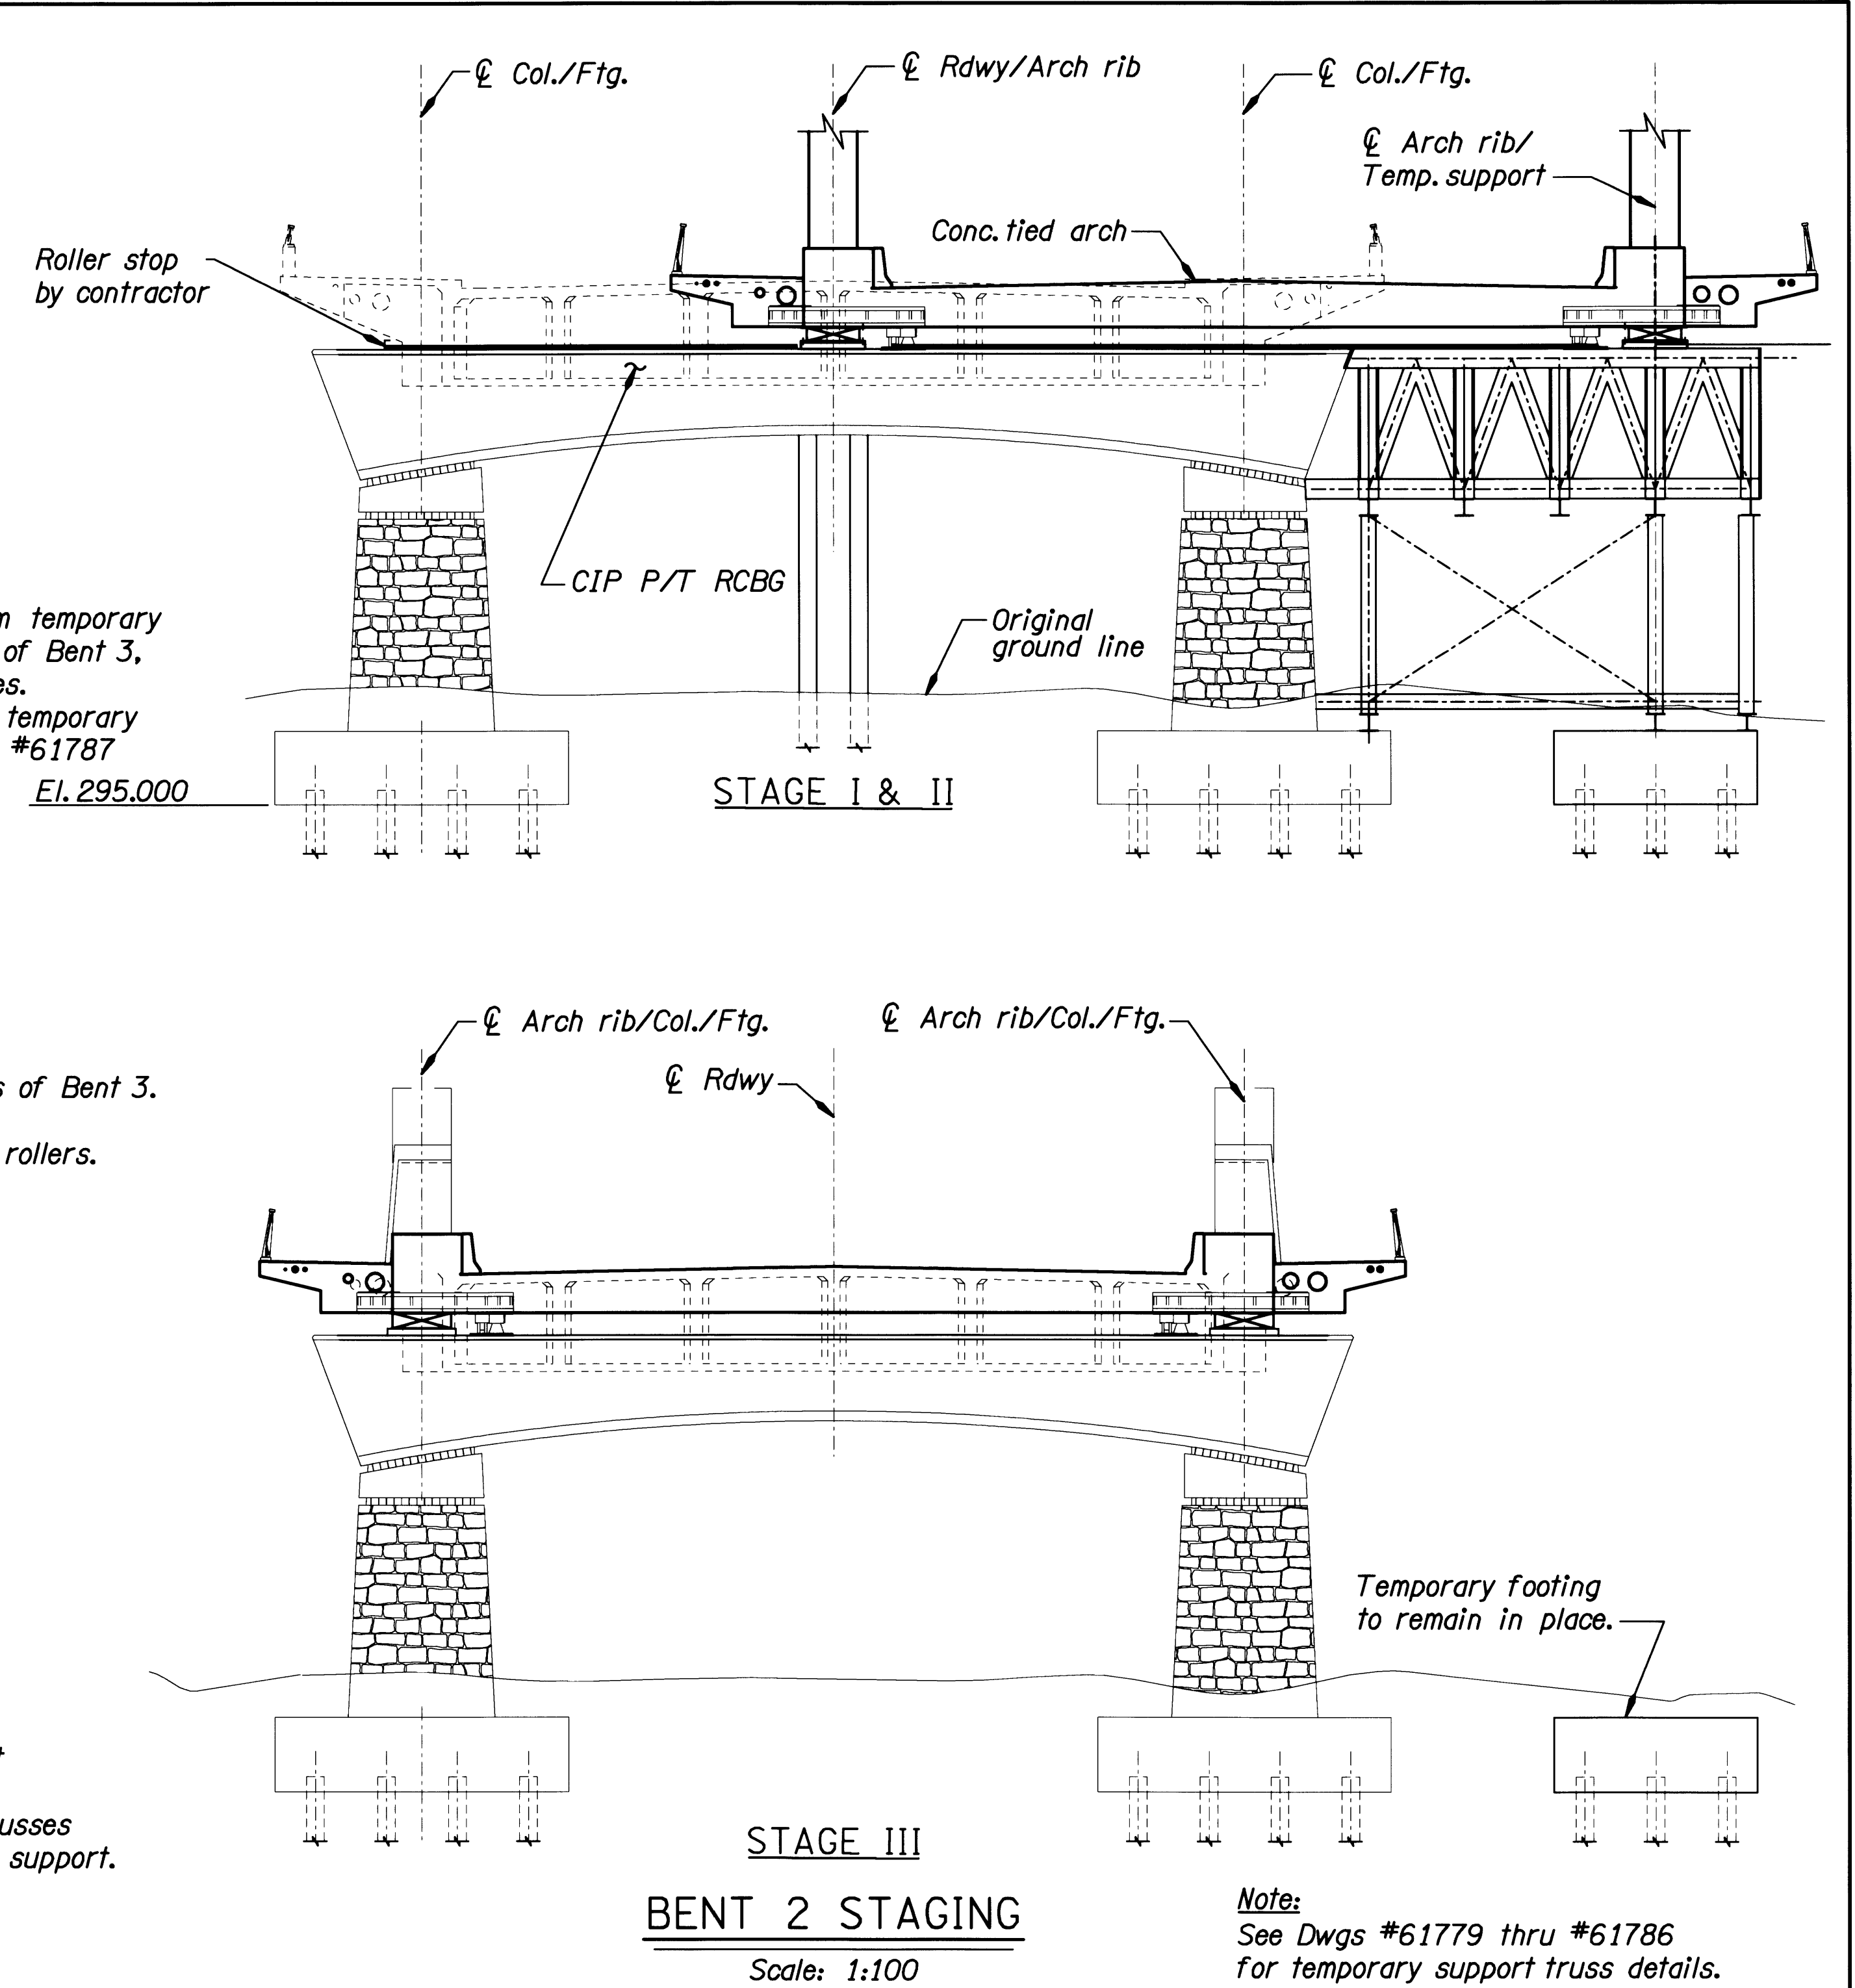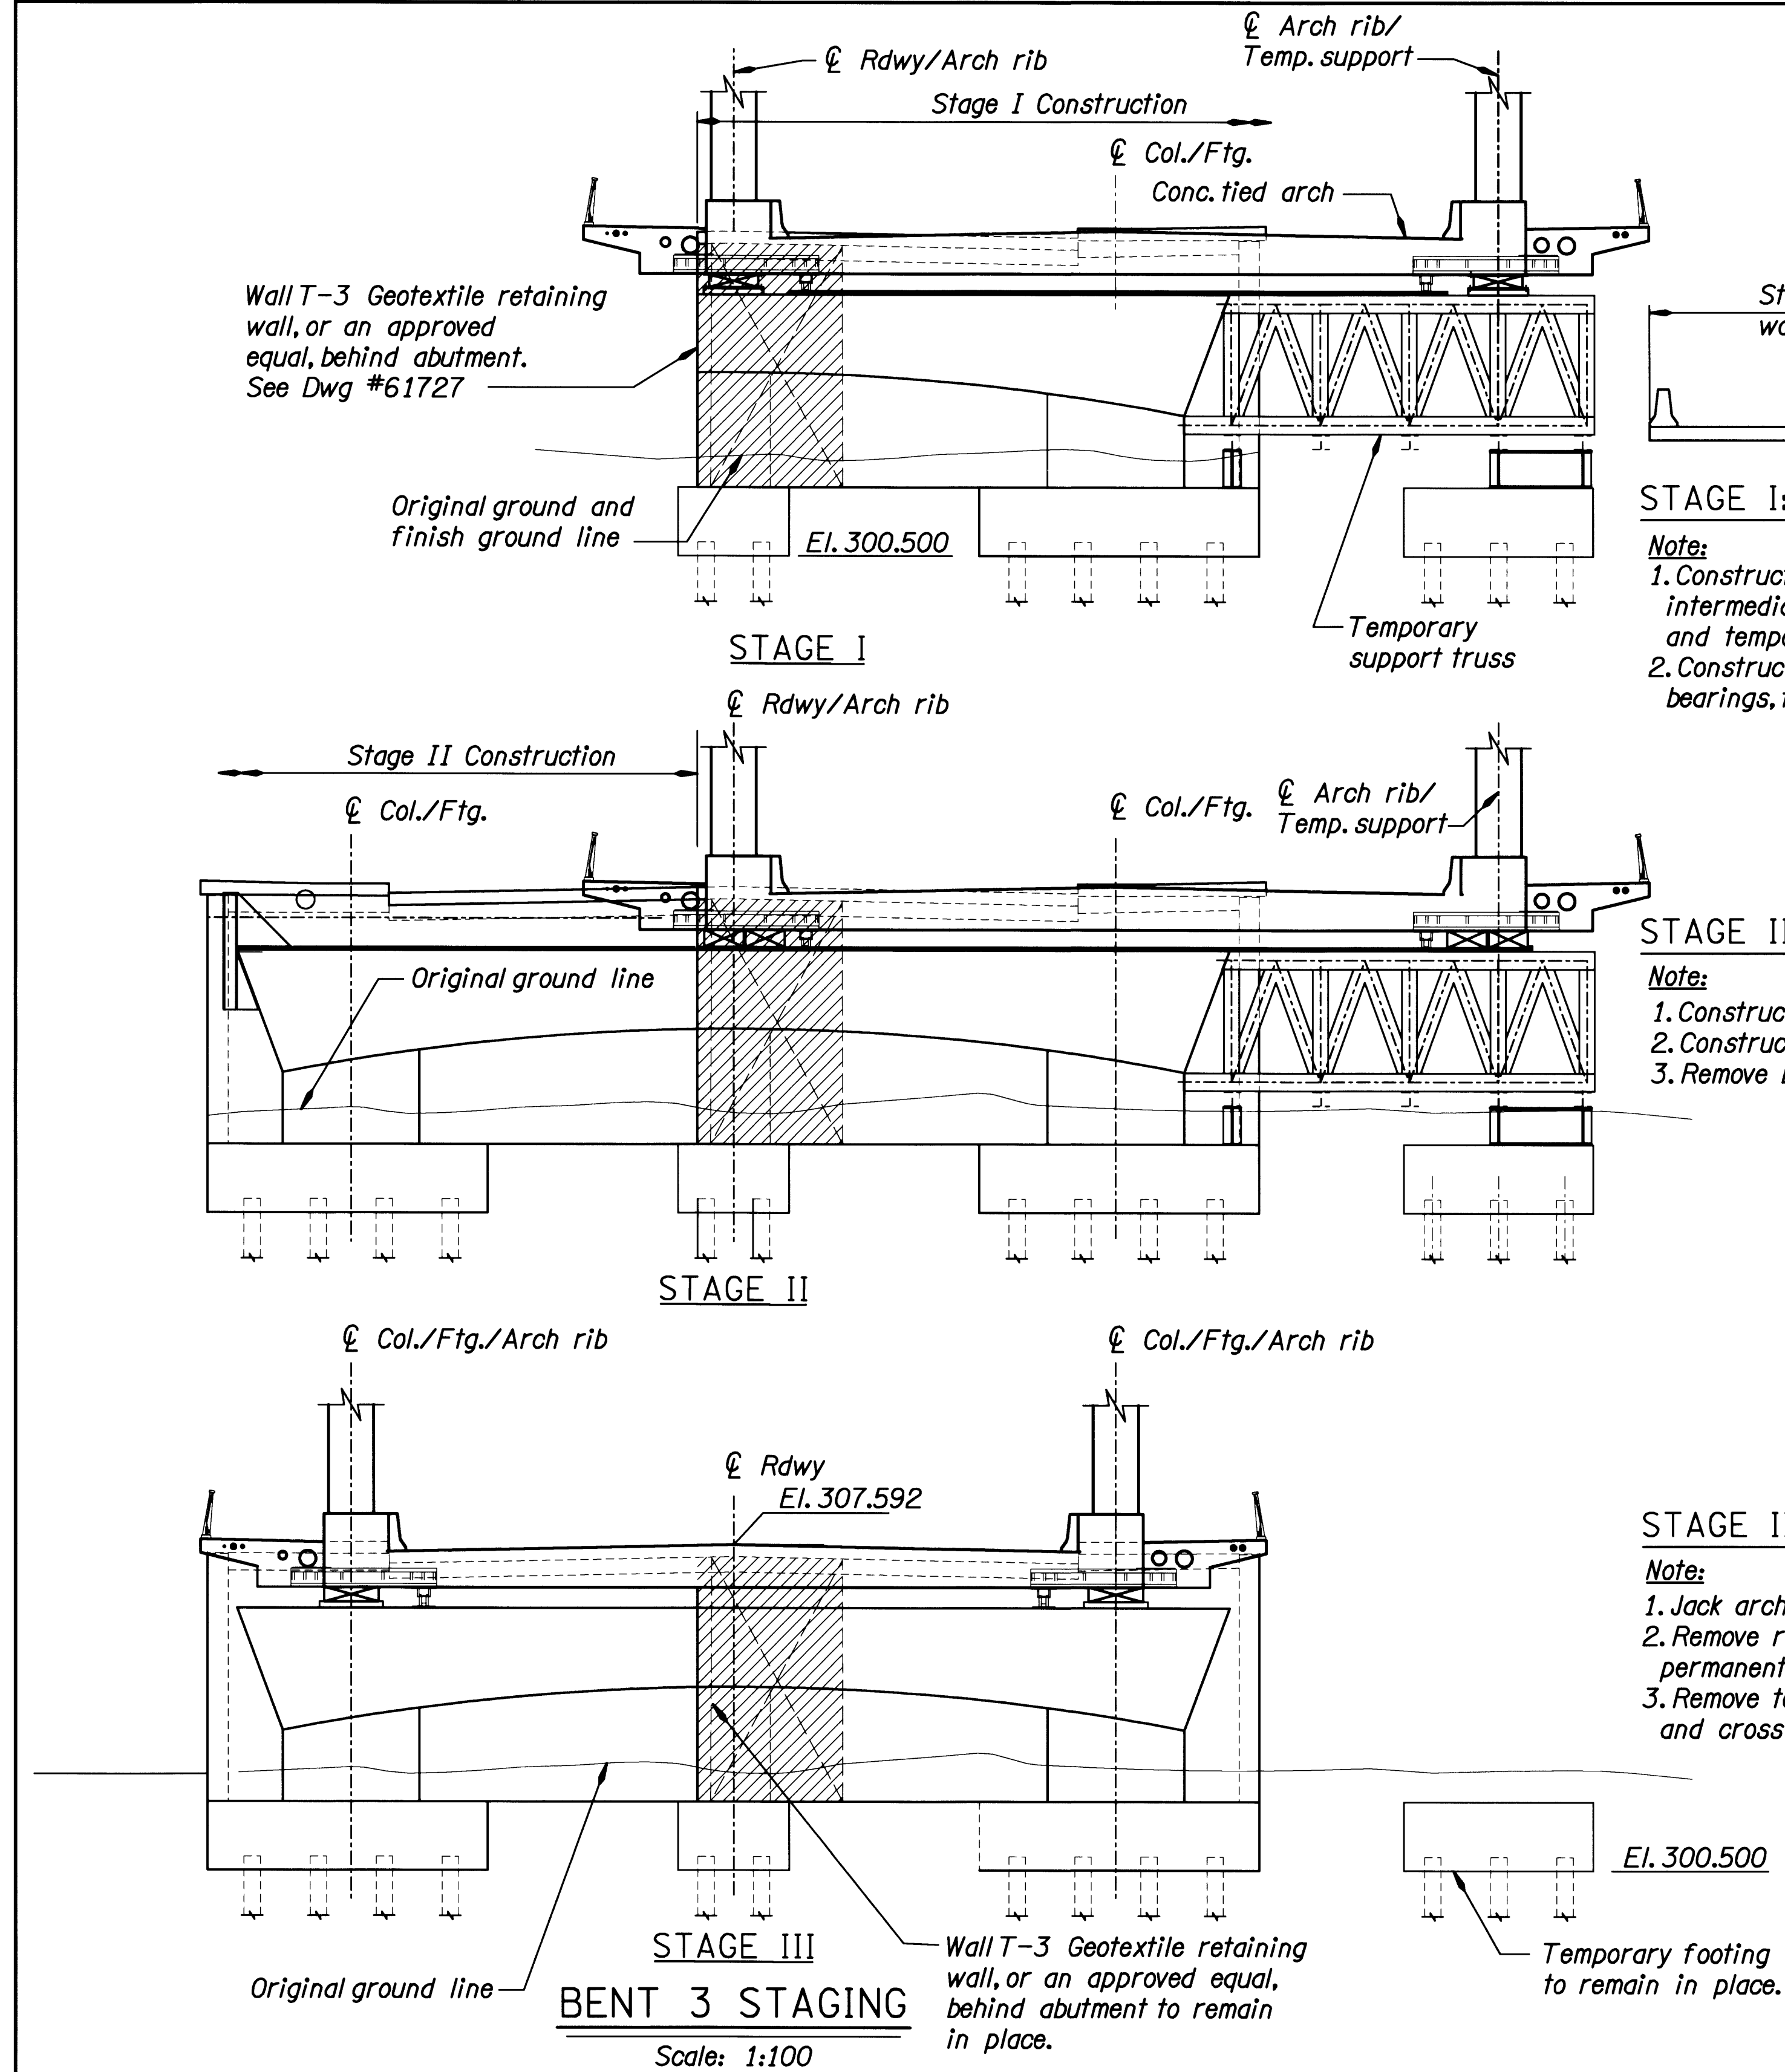

DATE	03/08	REVISION	AS CONSTRUCTED	BY	J. Culpepper	DESIGNER	DAVID EVANS AND ASSOCIATES INC.	BRIDGE NO.	19273	SHEET	8 OF 81
CHECKED:	Kent Cordtz	REVIEWED:	Terry Shike	EXP. DATE:	12-31-04	530 Center Street N.E., Suite 605 Salem Oregon 97301 Phone: 503.361.8635	OREGON DEPARTMENT OF TRANSPORTATION BRIDGE ENGINEERING SECTION	DATE	Nov. 2002	DRAWING NO.	61726
								CALC. BOOK	5081		
ROGUE RIVER (DEPOT STREET) BRIDGE										CONSTRUCTION STAGING SECTIONS	


Note:
All dimensions are in millimeters (mm) and all elevations are meters (m) except as noted.

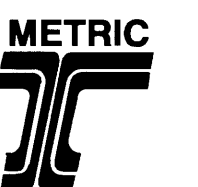

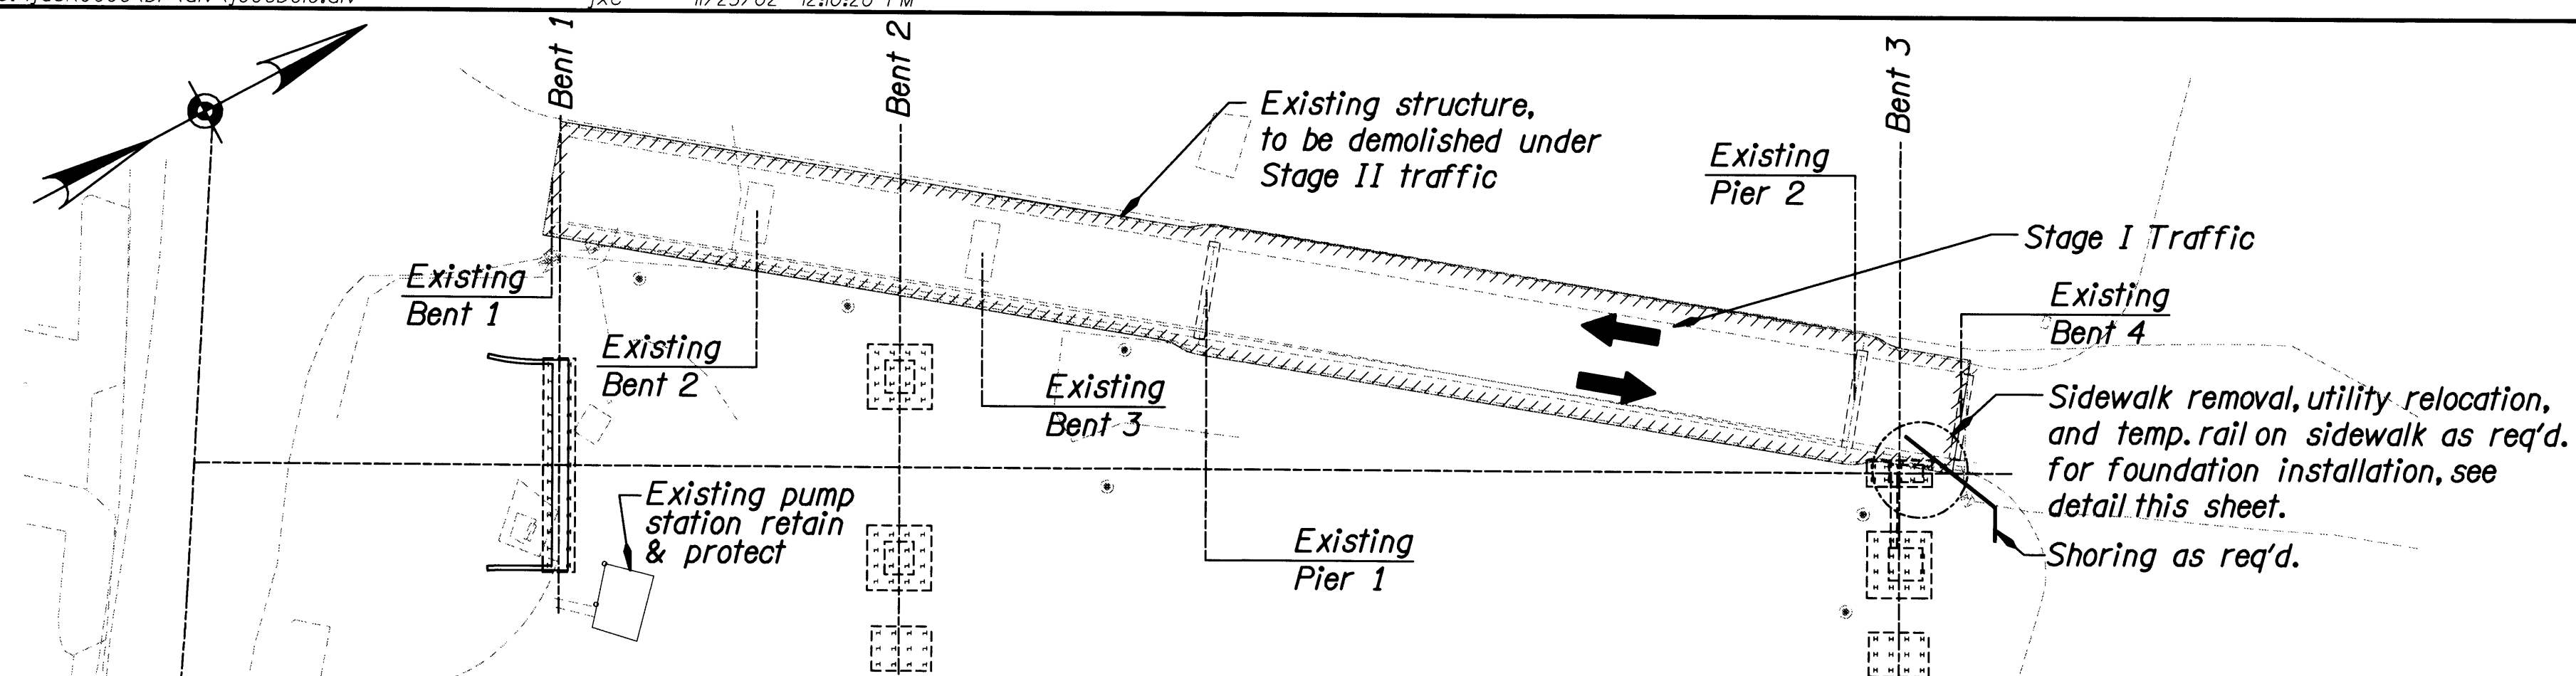


DEMOLITION PLAN

Scale: 1:500

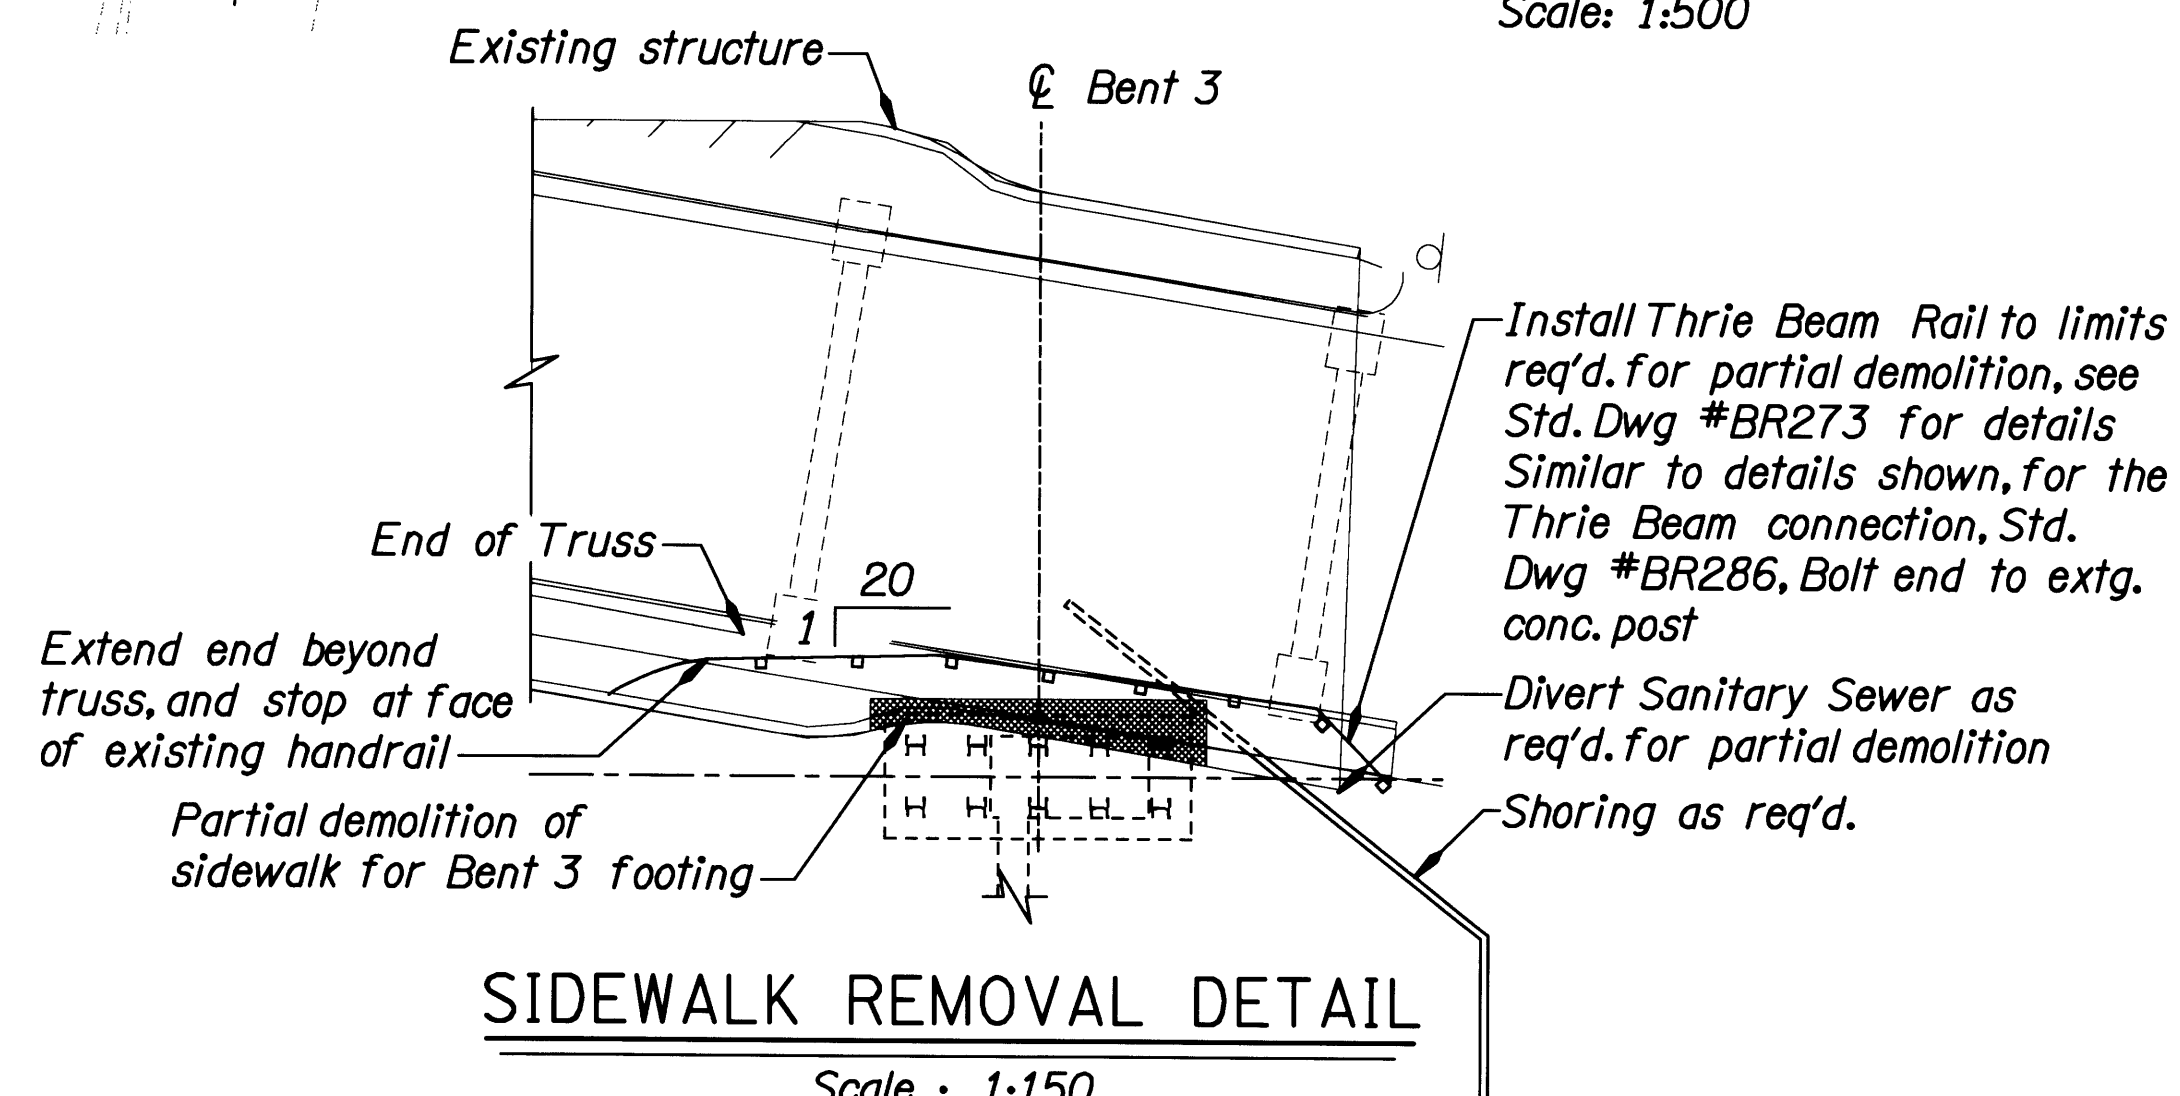


SIDEWALK REMOVAL DETAIL

Scale : 1:150

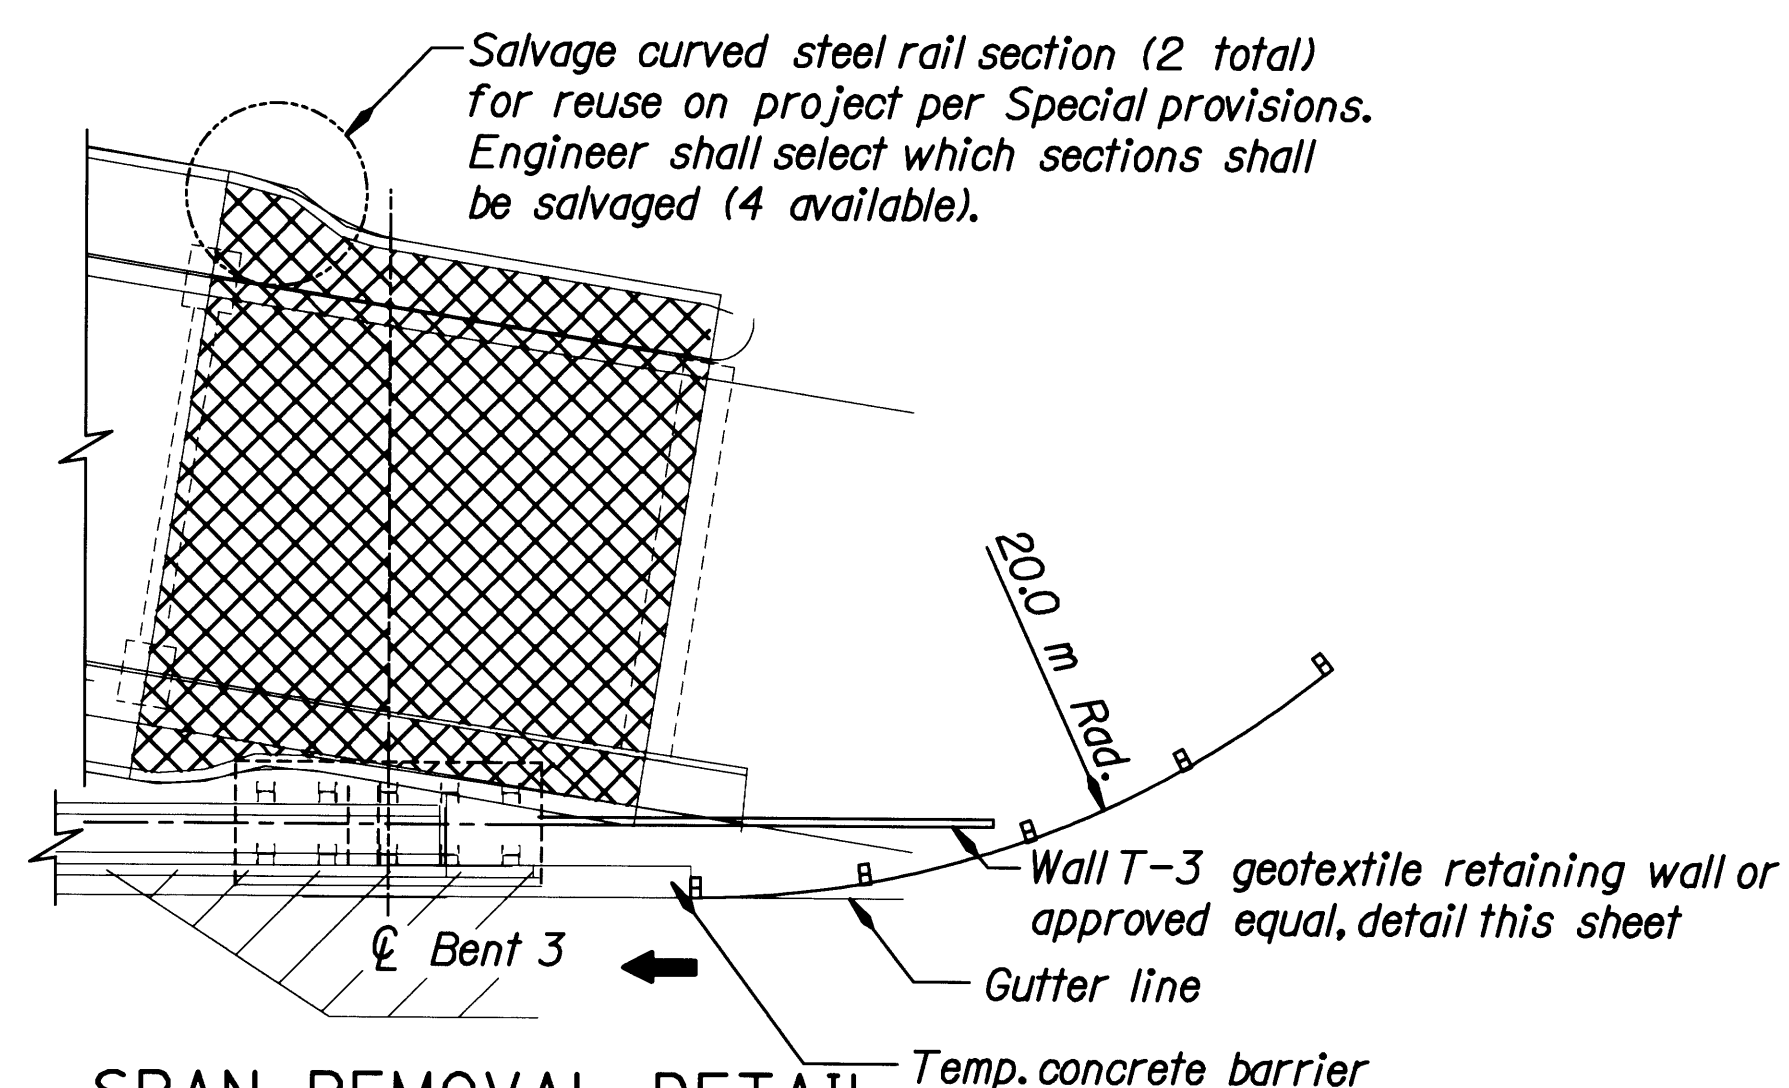


SPAN REMOVAL DETAIL

Scale : 1:150

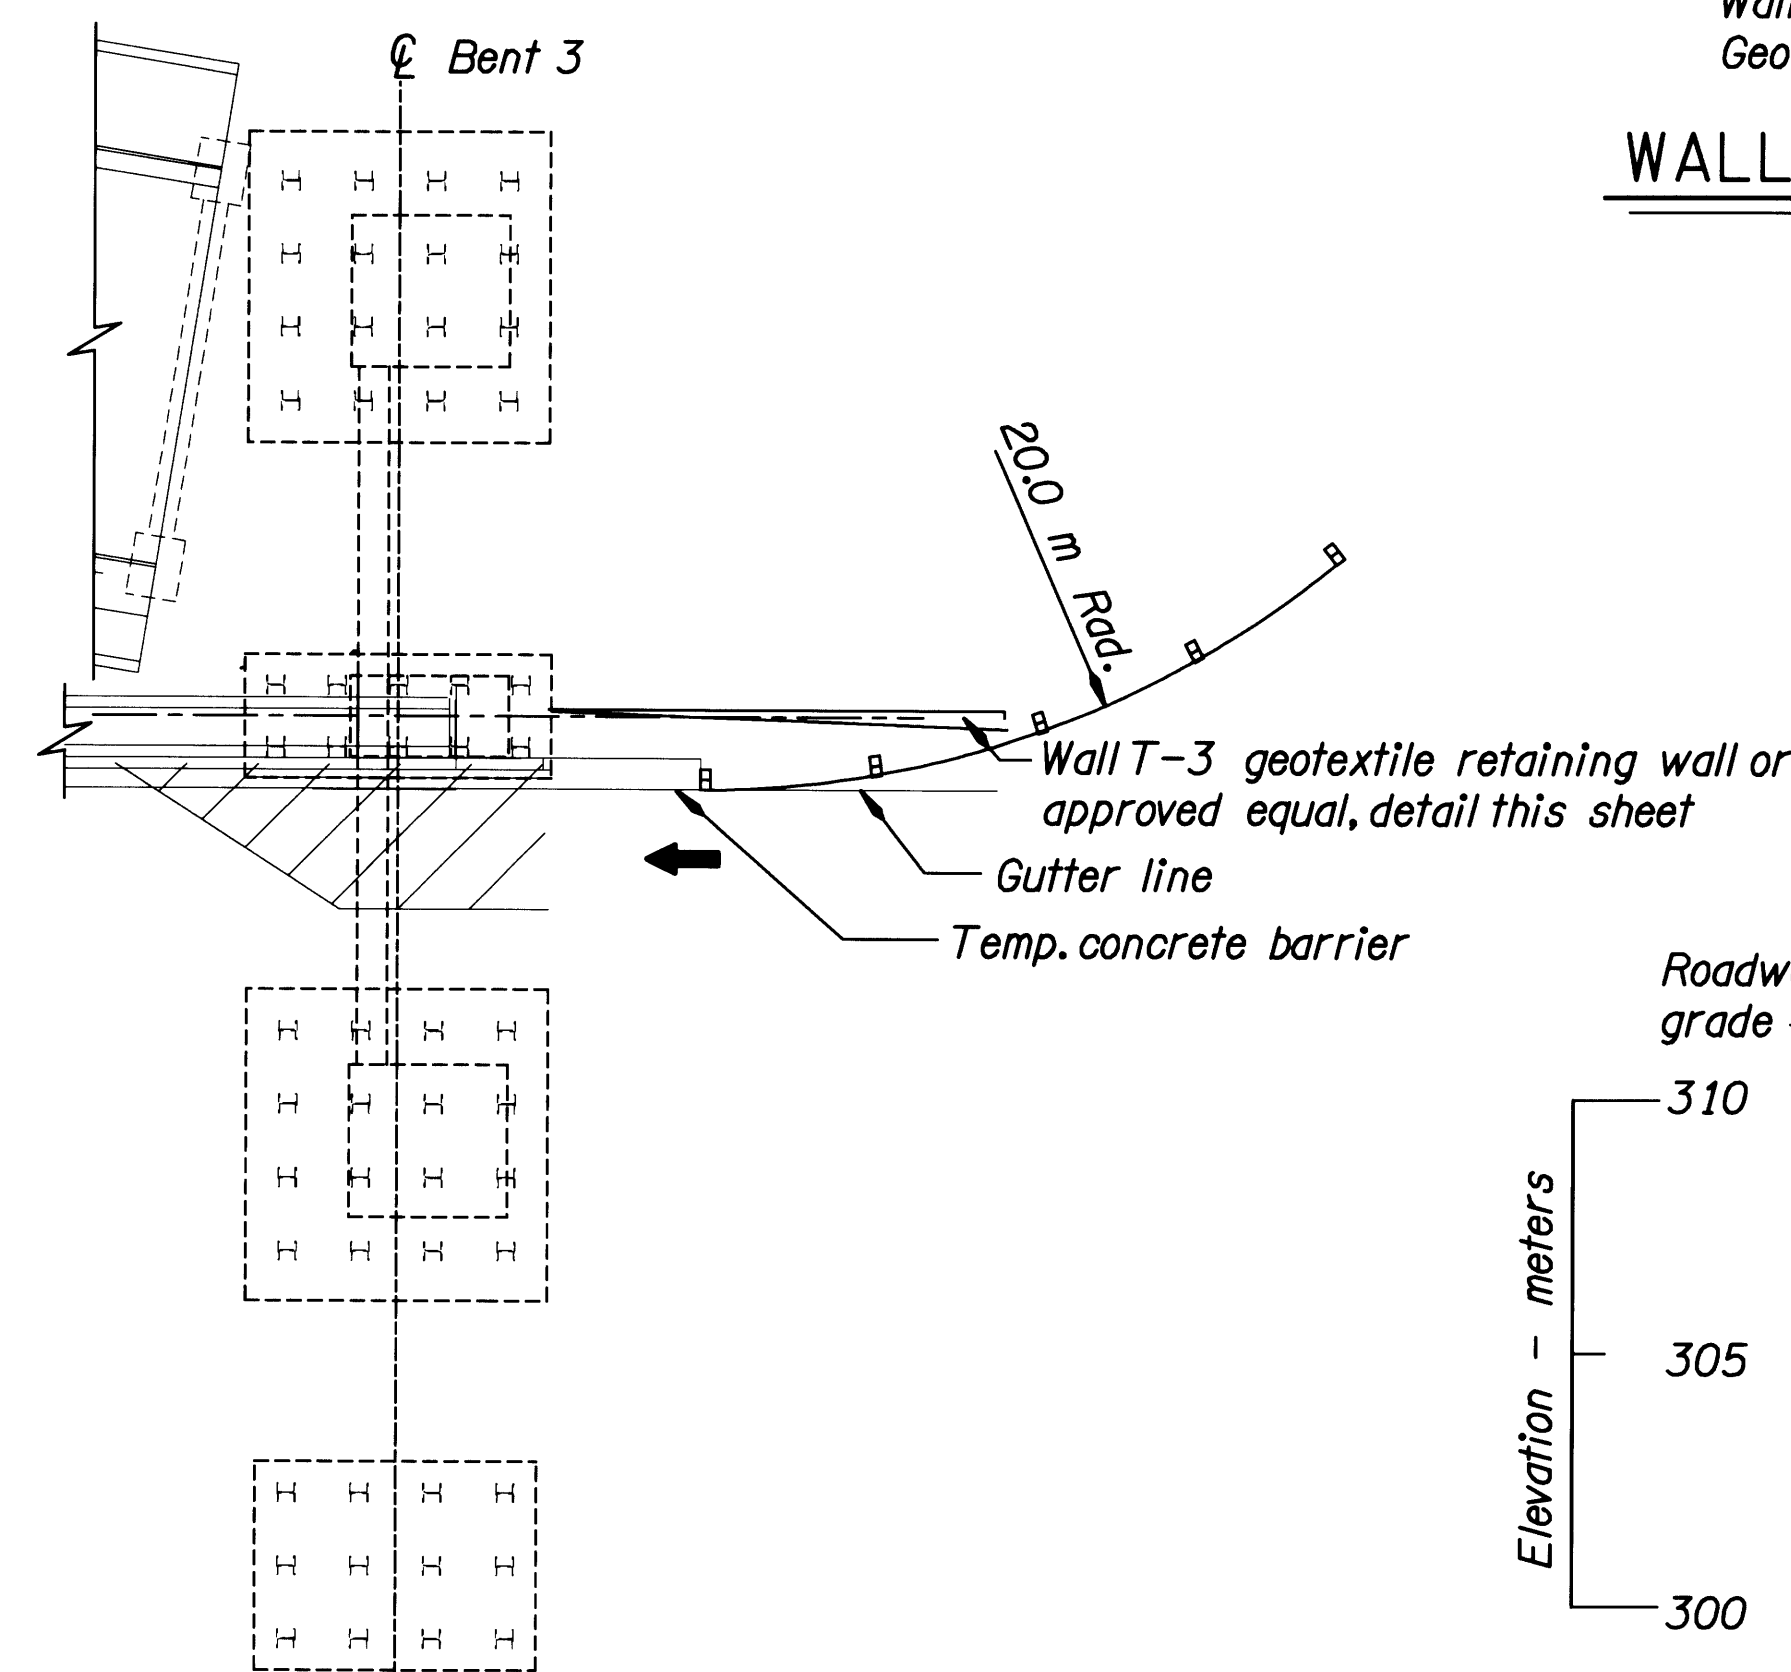


STAGE III - FINAL REMOVAL DETAIL

Scale : 1:150

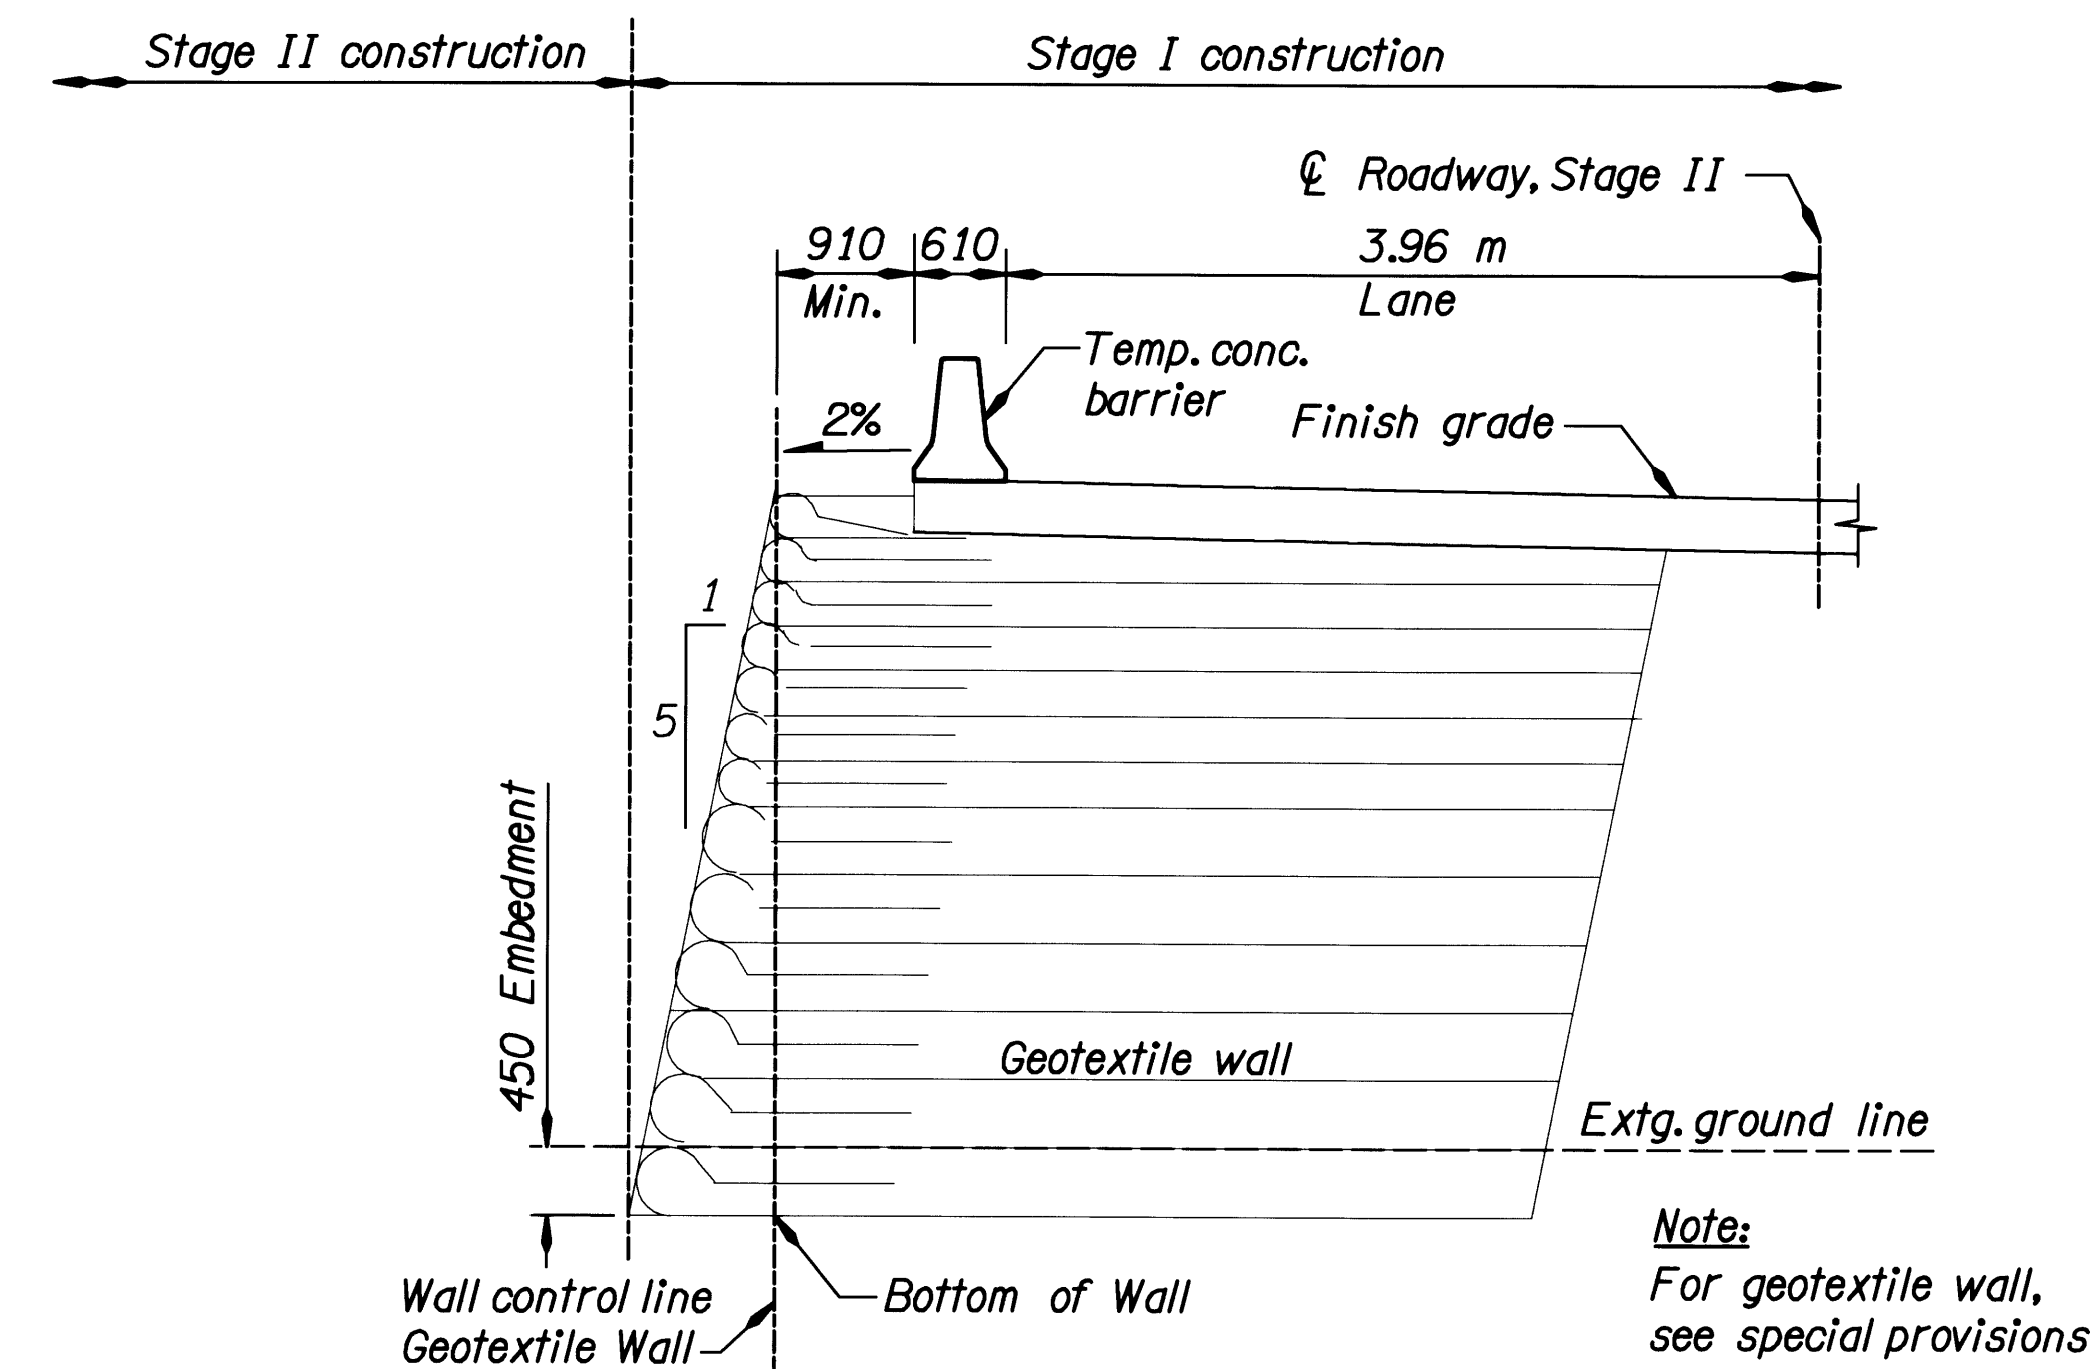

WALL T-3 GEOTEXTILE RETAINING WALL

Scale : 1:50

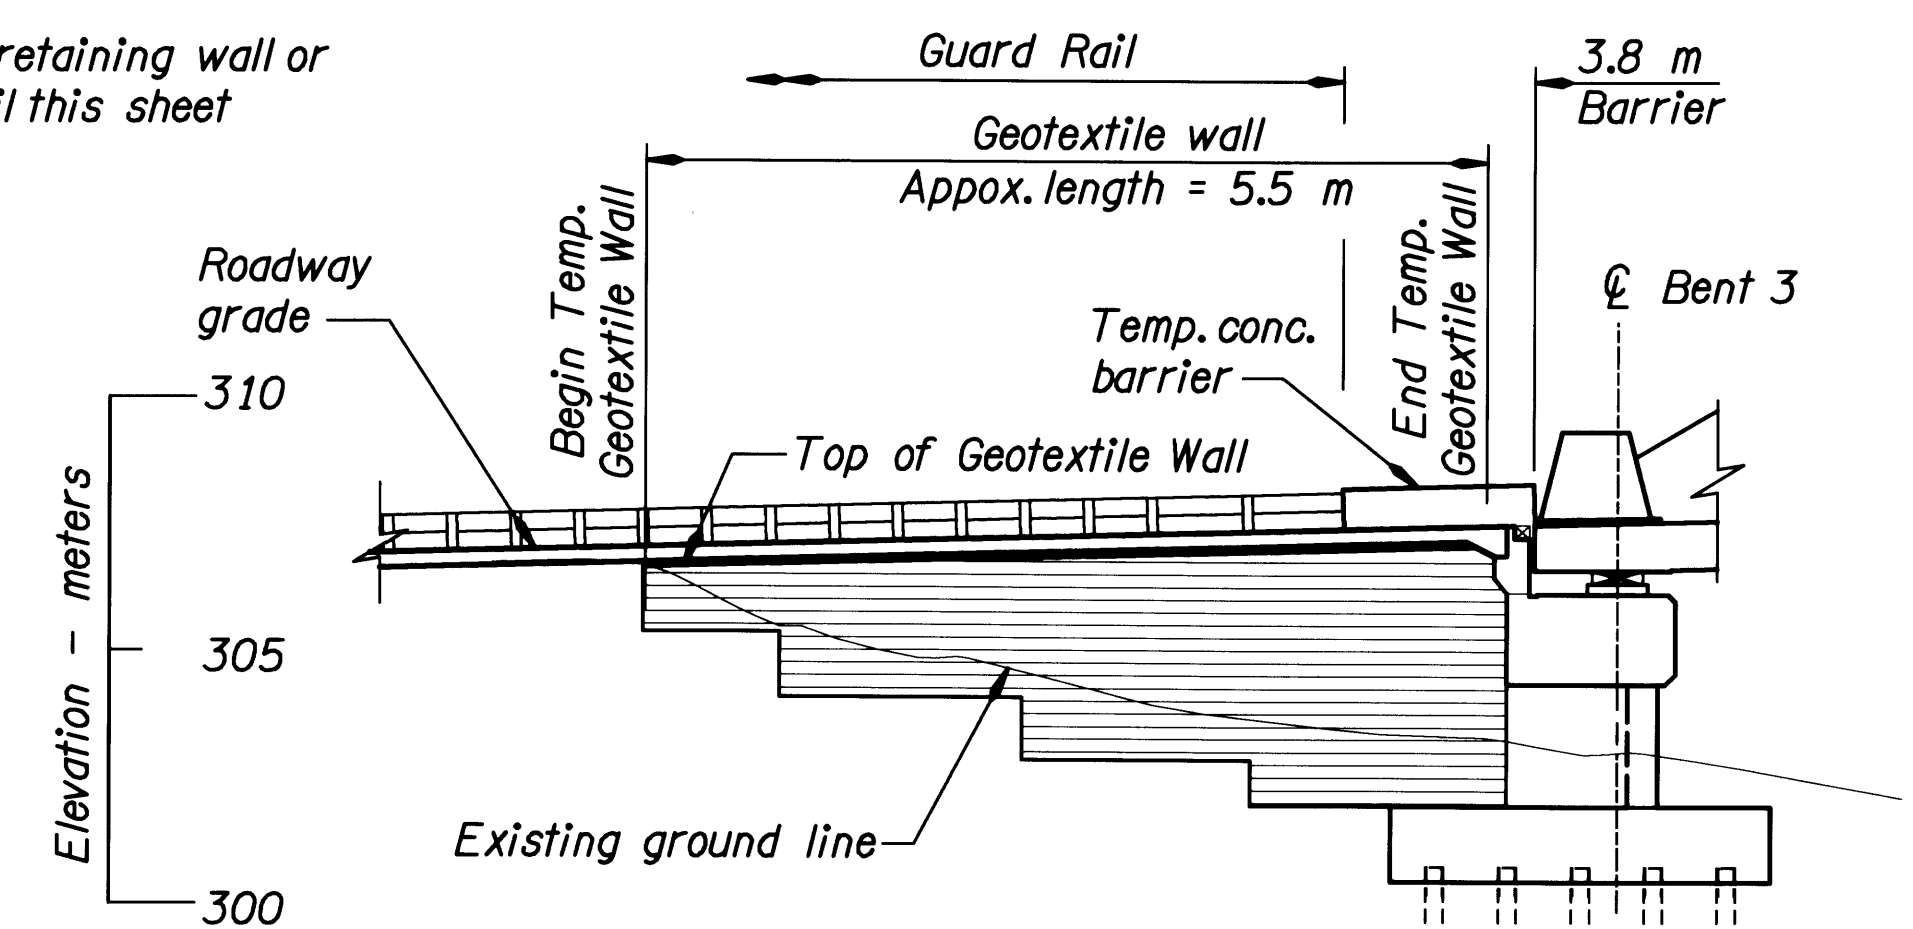


ELEVATION - WALL T-3 GEOTEXTILE WALL

Scale : 1:150

Note:
All dimensions are in millimeters (mm) and
all elevations are meters (m) except as noted.




	DATE	REVISION	BY	DRAFTED: <i>J. Culpepper</i> CHECKED: <i>Kent Cordtz</i> <i>Kent Cordtz</i> REVIEWED: <i>Terry Shike</i> <i>Terry Shike</i>	DESIGNER  DAVID EVANS AND ASSOCIATES INC. 530 Center Street N.E., Suite 605 Salem Oregon 97301 Phone: 503.361.8635	 OREGON DEPARTMENT OF TRANSPORTATION BRIDGE ENGINEERING SECTION	BRIDGE NO. 19273	ROGUE RIVER (DEPOT STREET) BRIDGE	SHEET 9 OF 81				
							DATE Nov. 2002						
											CALC. BOOK 5081	DEMOLITION PLAN AND WALL T-3	DRAWING NO. 61727

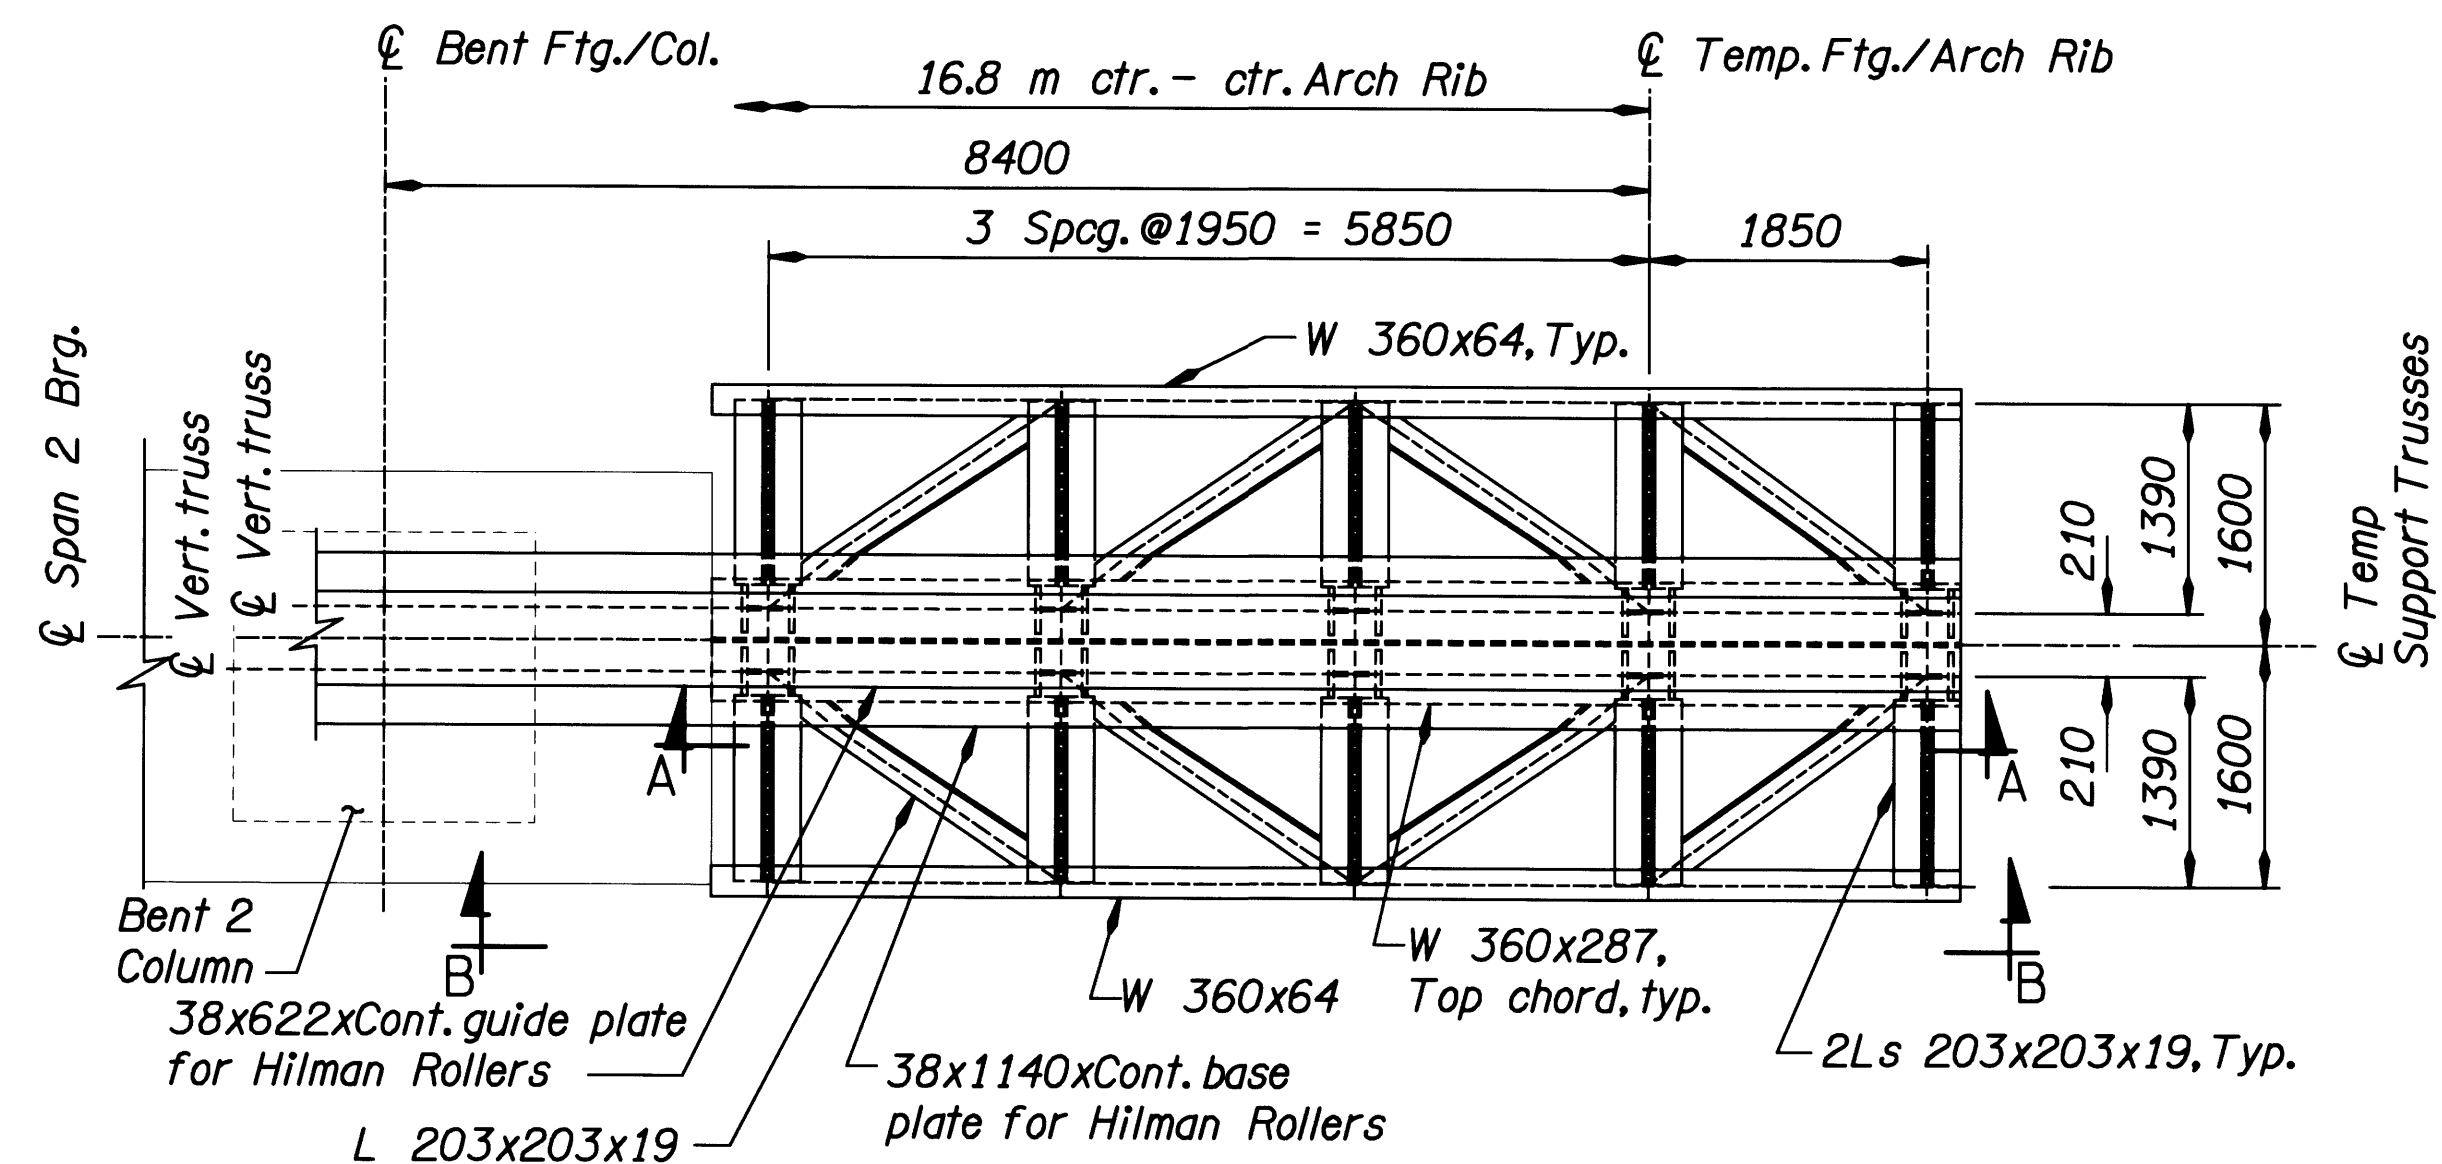

PLAN - TEMPORARY SUPPORT TRUSS
BENT 2 SHOWN (BENT 3 SIMILAR)

Scale : 1:50

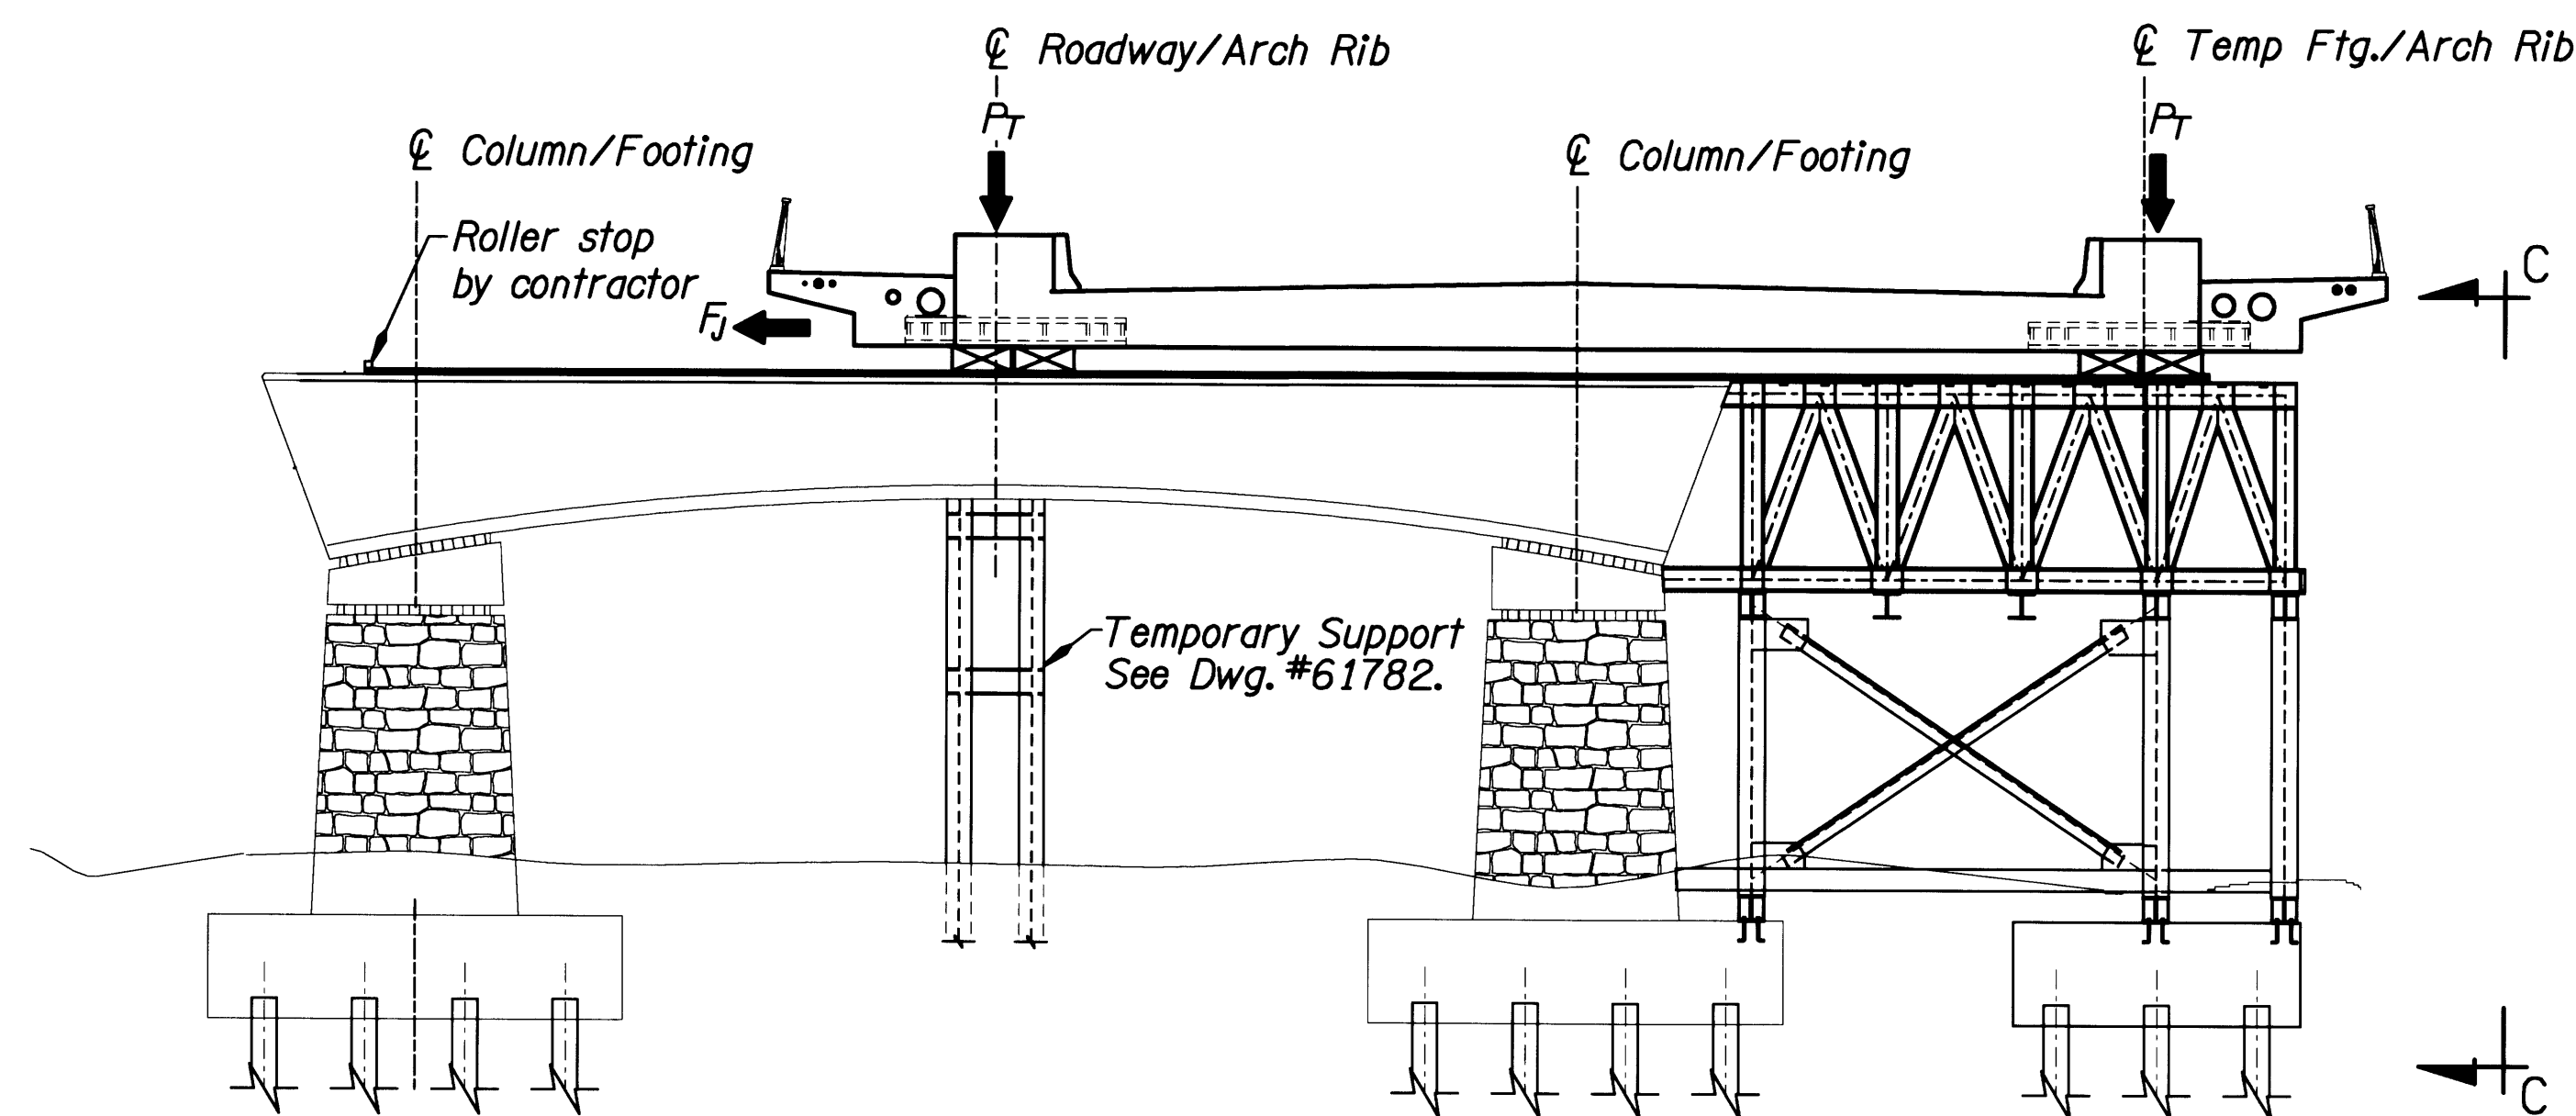

HORIZONTAL JACKING DIAGRAM
(BENT 2 SHOWN, BENT 3 SIMILAR)


Scale : 1:100

Note:

For bearing staging sequence,
see Dwg #61787.

For jacking support beam detail,
see Dwg #61767.

For temporary support trusses, see
Dwgs #61780-#61784.

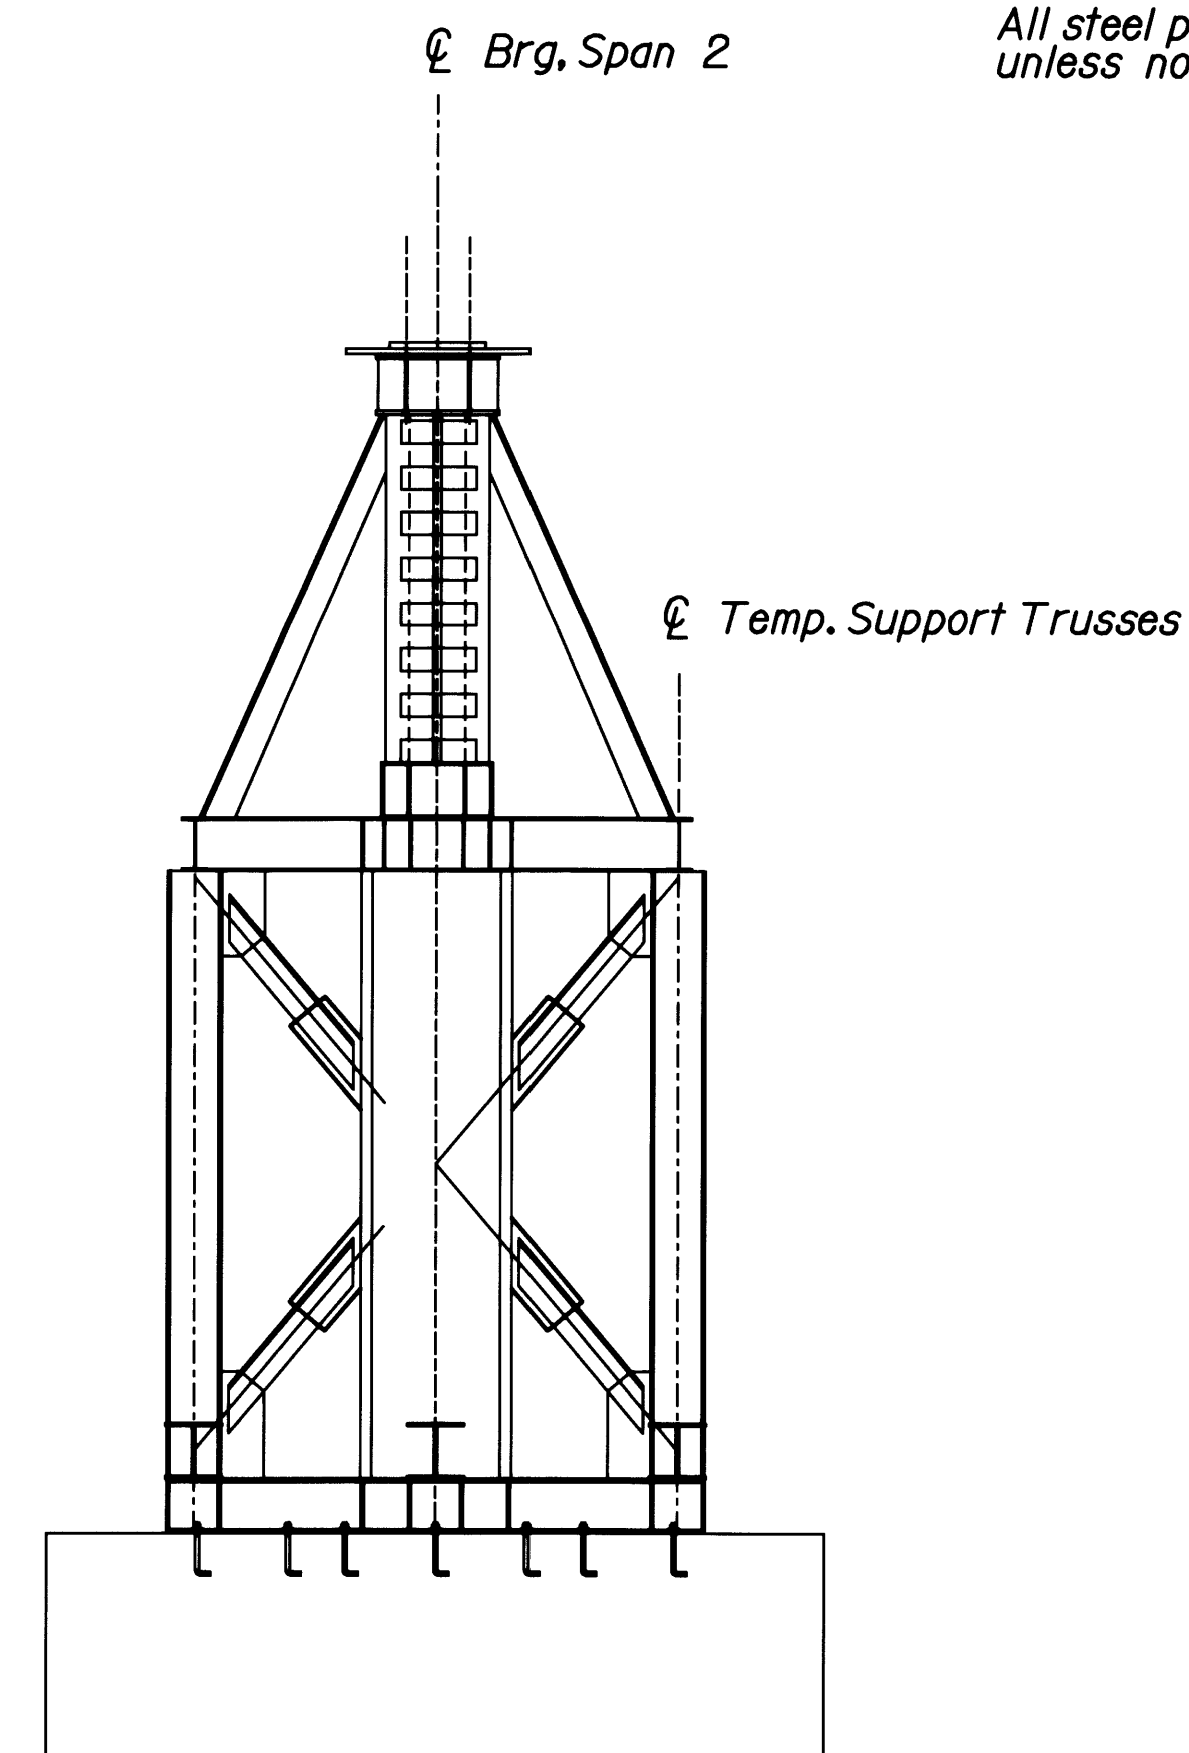

SECTION C-C


Scale : 1:50

Note:

All dimensions are in millimeters (mm) and
all elevations are meters (m) except as noted.




DATE	03/08	REVISION	AS CONSTRUCTED	BY	AVS	DRAFTED:	M.C. Young	CHECKED:	Kent Cordtz	REVIEWED:	Terry Shike	DESIGNER	DAVID EVANS AND ASSOCIATES INC.	BRIDGE NO.	19273	DATE	Nov. 2002	CALC. BOOK	5081	ROGUE RIVER (DEPOT STREET) BRIDGE	HORIZONTAL JACKING SYSTEM FORCE DIAGRAM	SHEET	61 OF 81	DRAWING NO.	61779
------	-------	----------	----------------	----	-----	----------	------------	----------	-------------	-----------	-------------	----------	---------------------------------	------------	-------	------	-----------	------------	------	-----------------------------------	---	-------	----------	-------------	-------

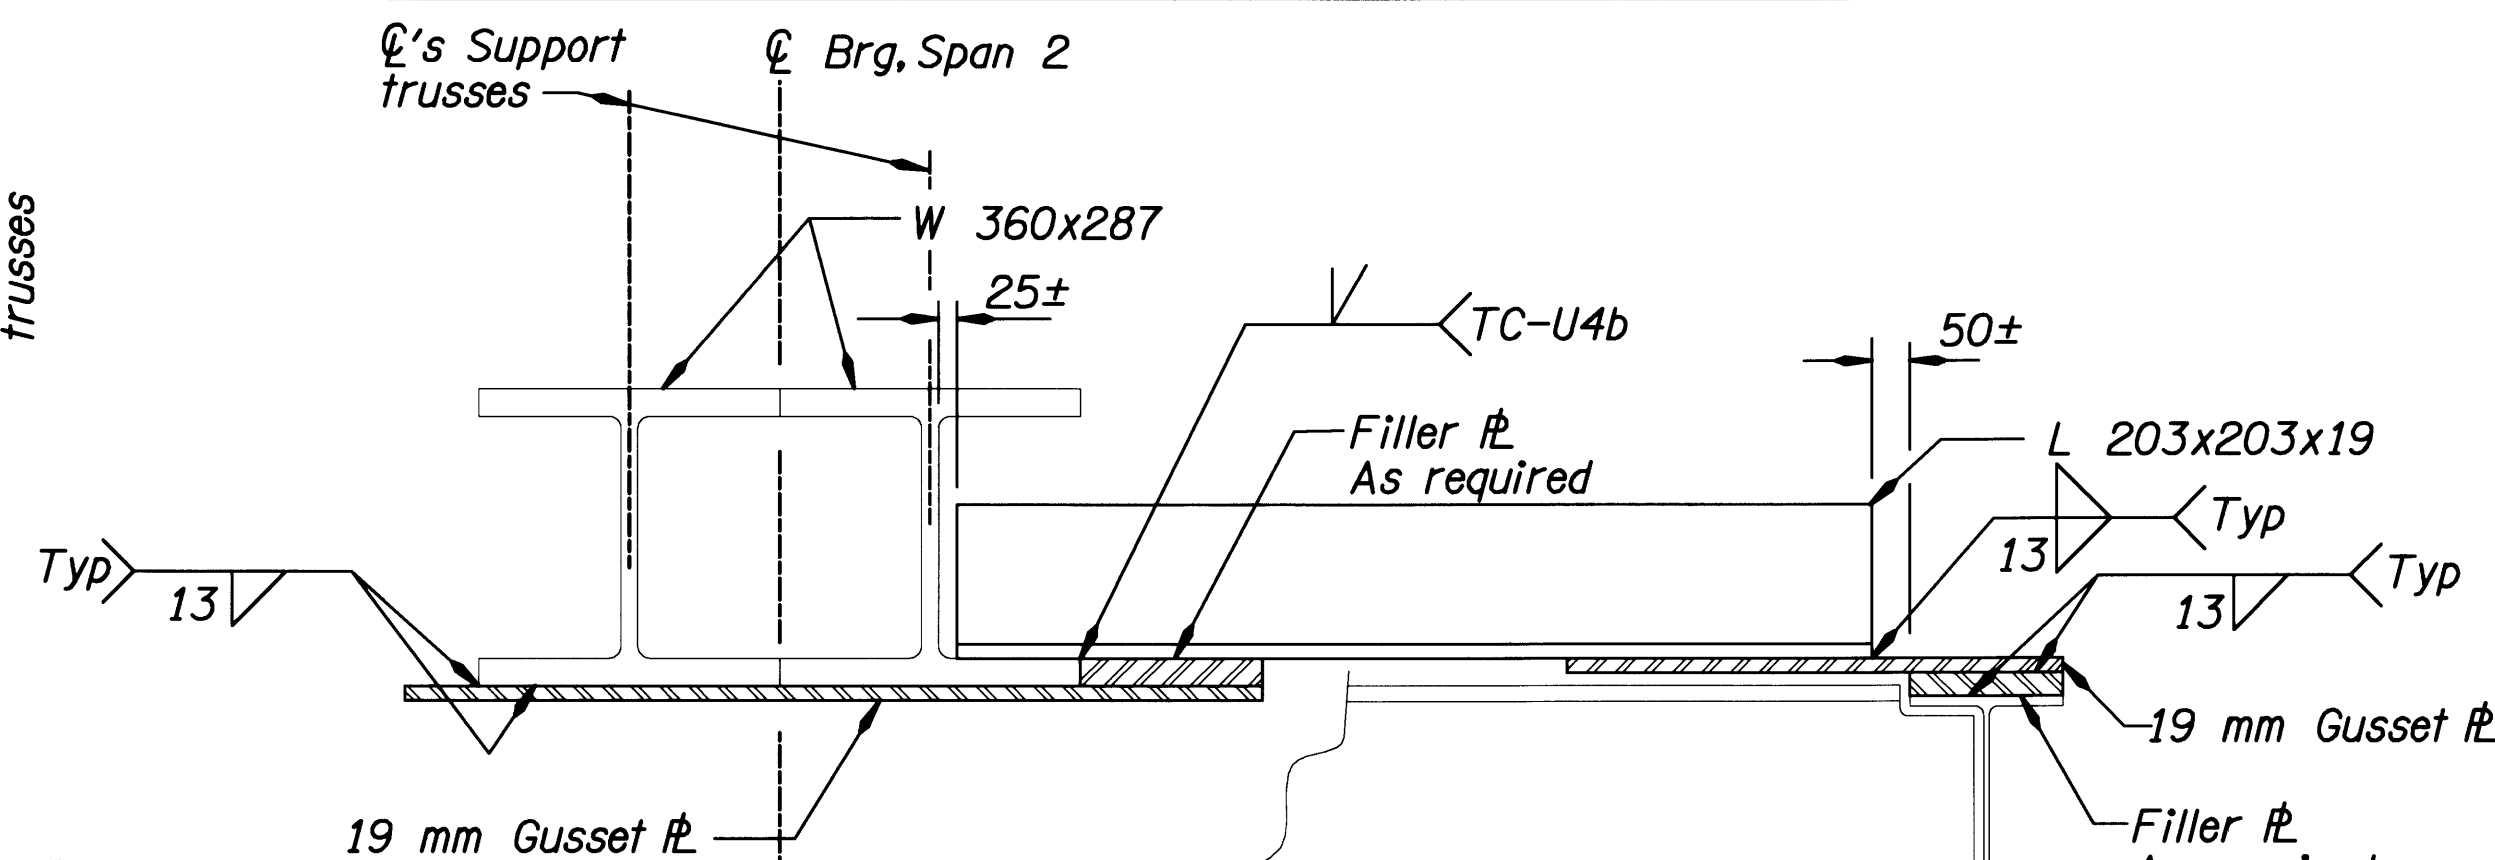

SECTION "F-F"

Scale : 1:10

Connections for Bearing and Bearing Guide
to Support Truss are by contractor.
See Dwg. #61779 for location of Sections A-A and B-B.
For sections "C-C" and "D-D" see Dwg #61782
For Details "A" thru "F", see Dwg #61783
For Details "G" thru "P", see Dwg #61784

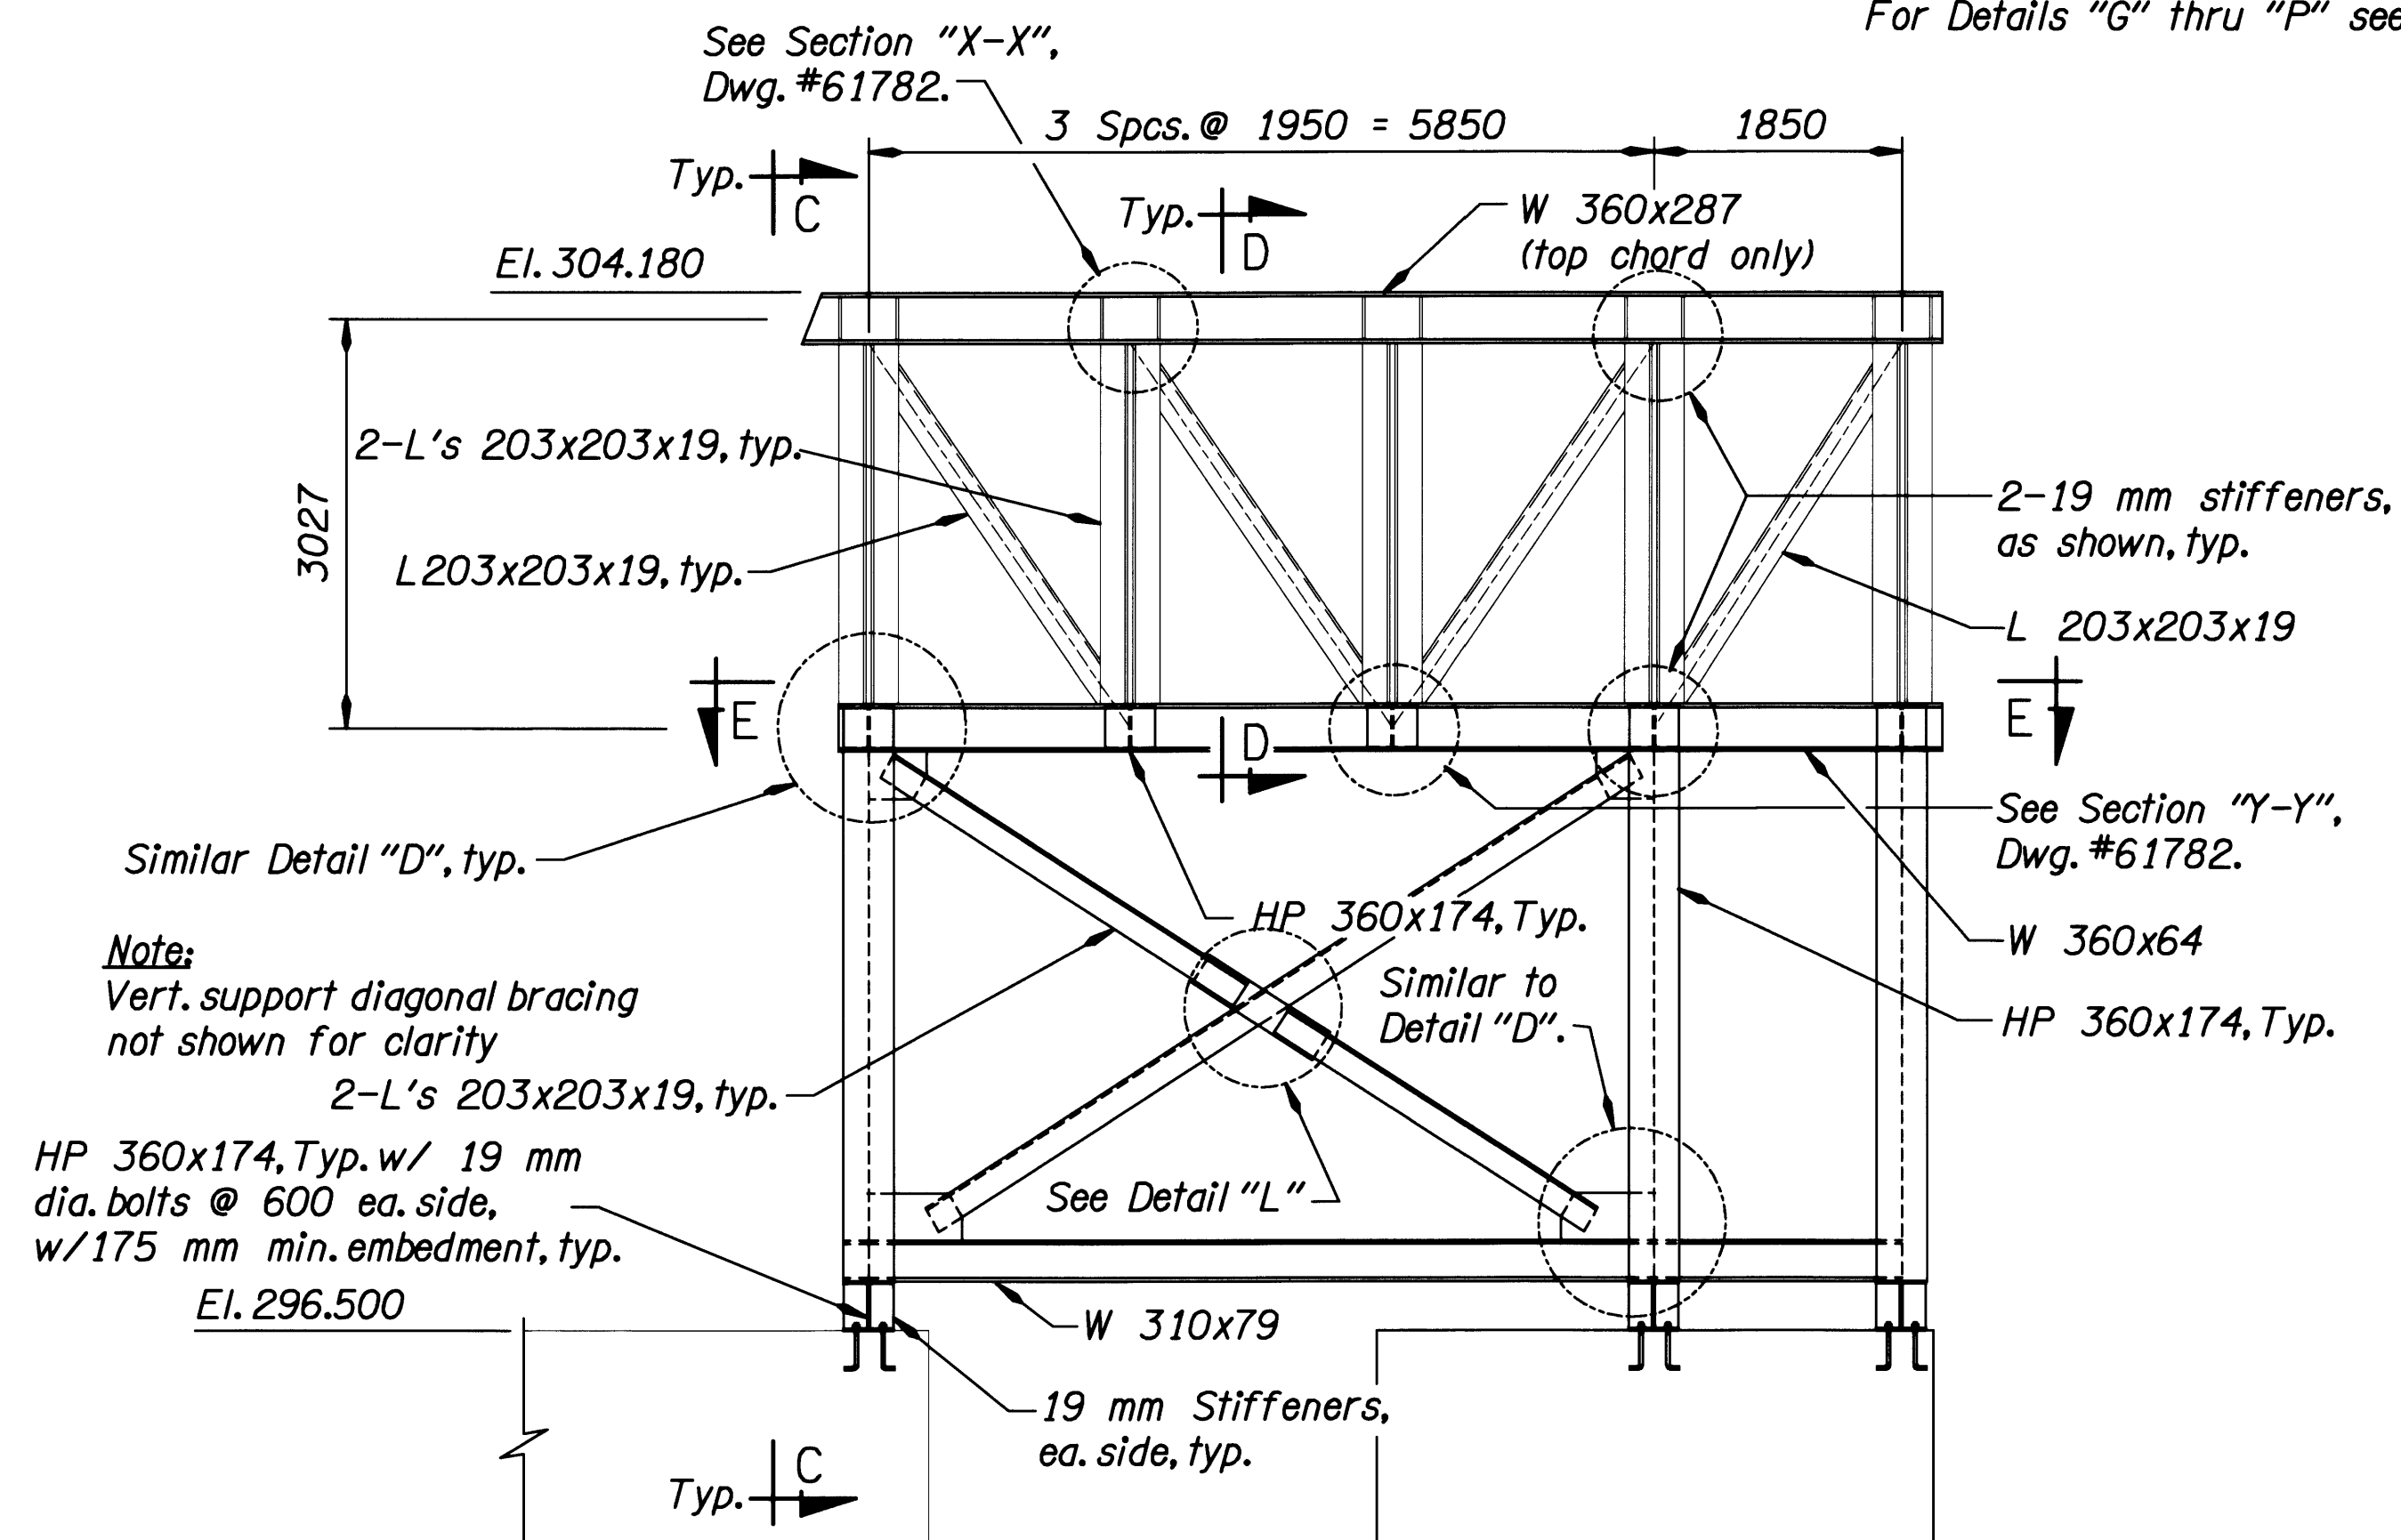




SECTION B-B (BENT 2 TEMPORARY LATERAL SUPPORT TRUSS)
ELEVATION AT EXTERIOR TRUSS

Scale : 1:50






Note:
All dimensions are in millimeters (mm) and
all elevations are meters (m) except as noted.



 OREGON DEPARTMENT OF TRANSPORTATION BRIDGE ENGINEERING SECTION	BRIDGE NO. 19273		ROGUE RIVER (DEPOT STREET) BRIDGE	SHEET 62 OF 81
	DATE Nov. 2002			
	CALC. BOOK 5081			
TEMPORARY SUPPORT TRUSS		DRAWING NO. 61780		

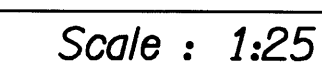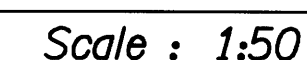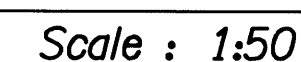


DRAWING NO.
61781

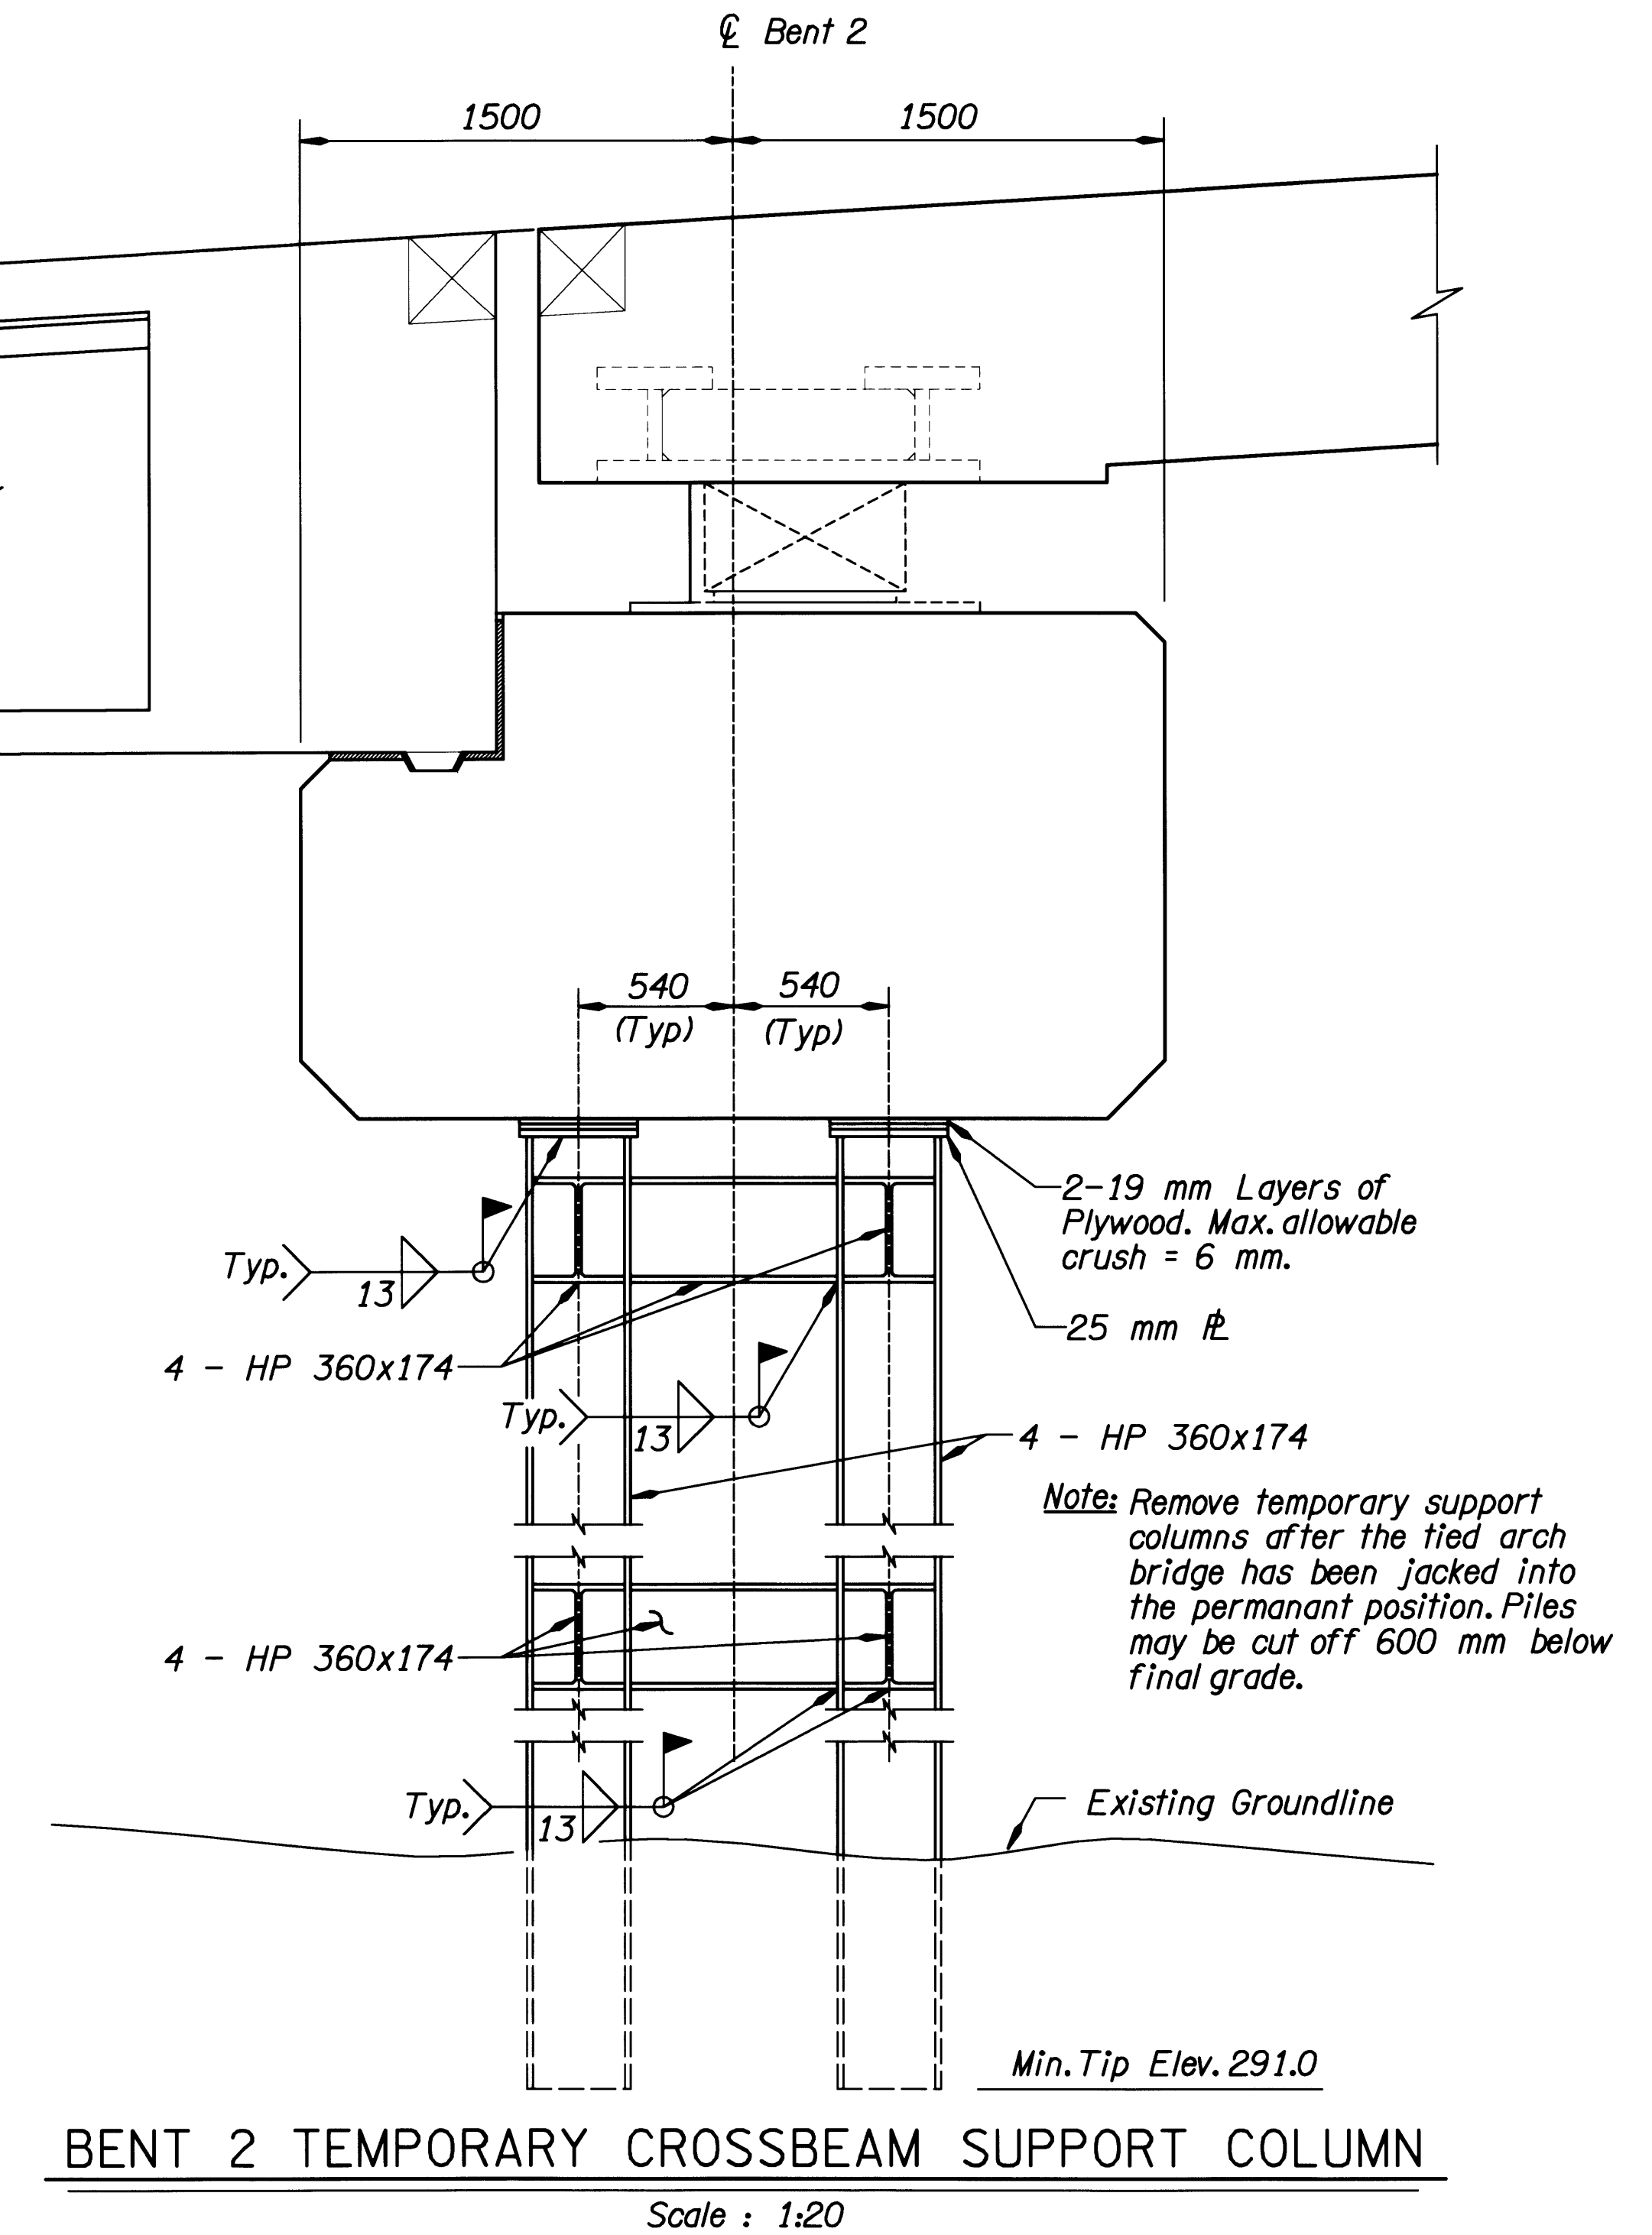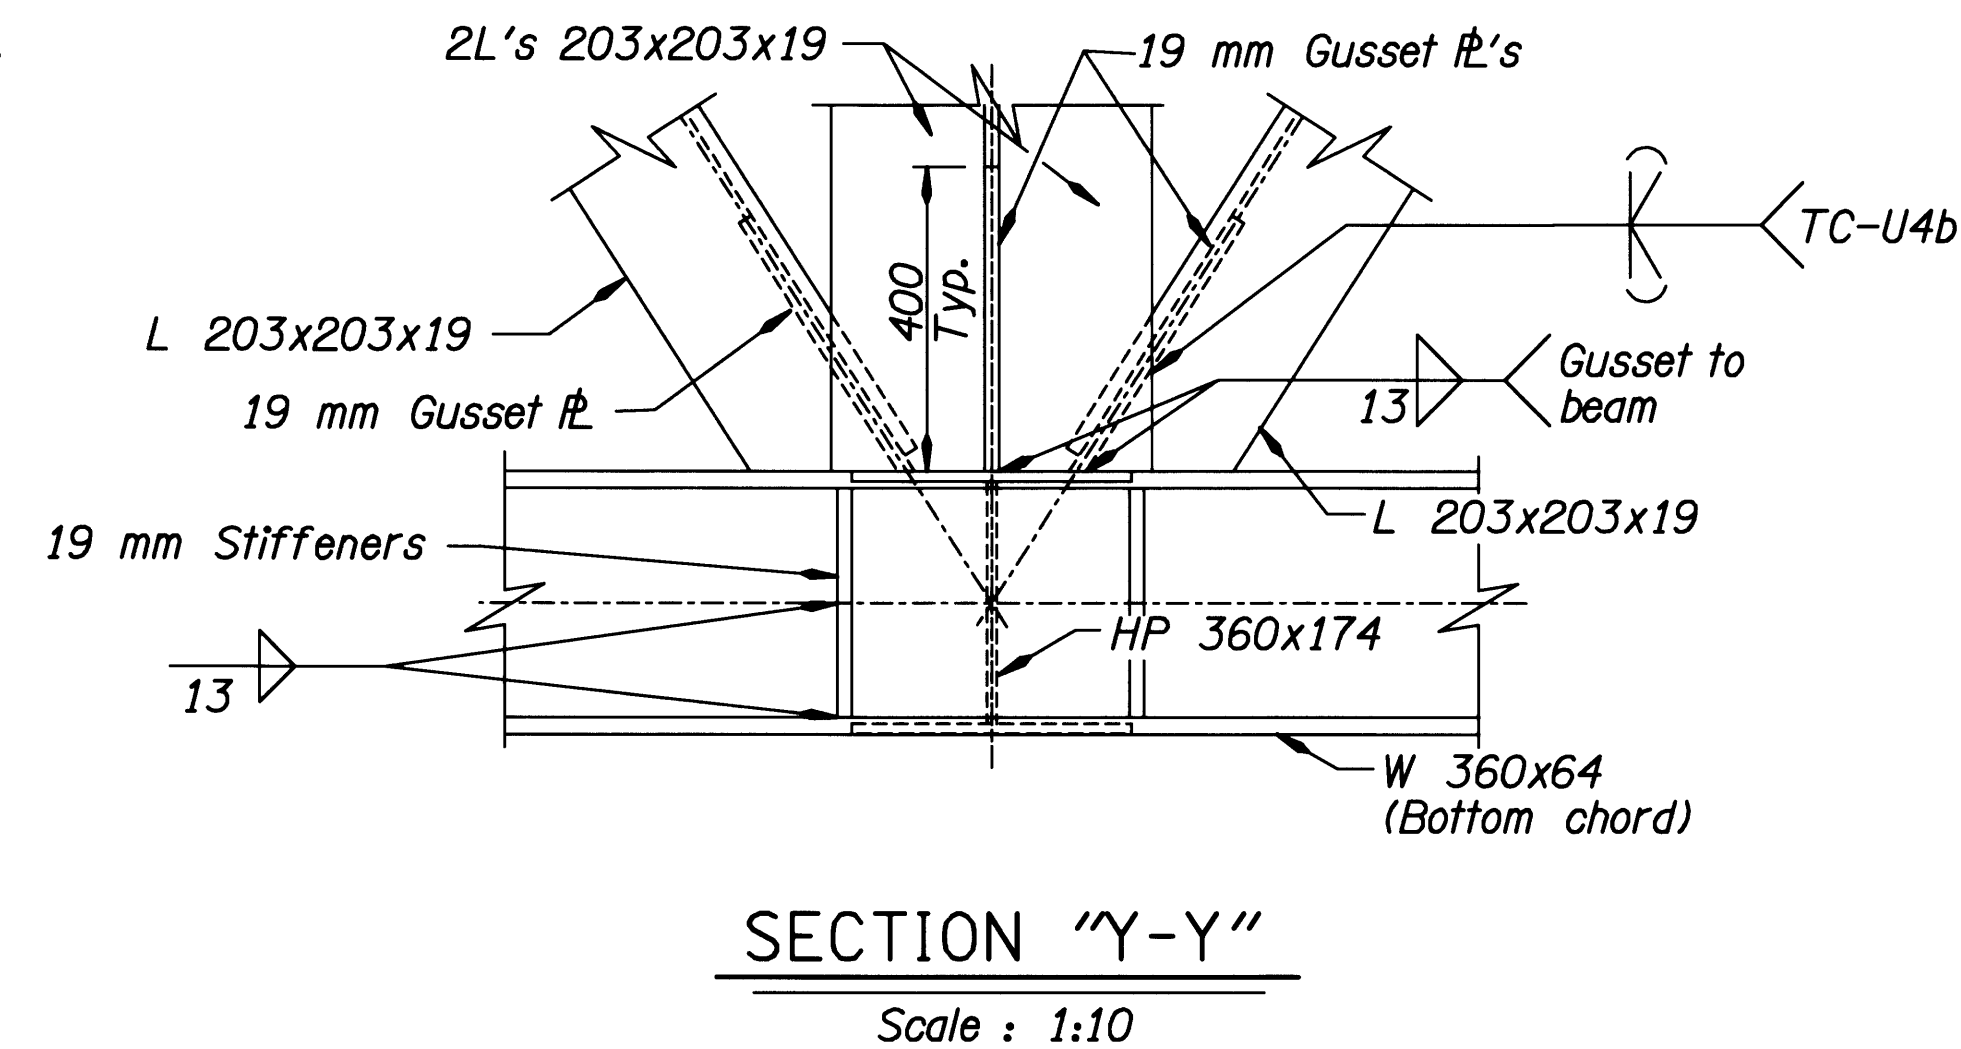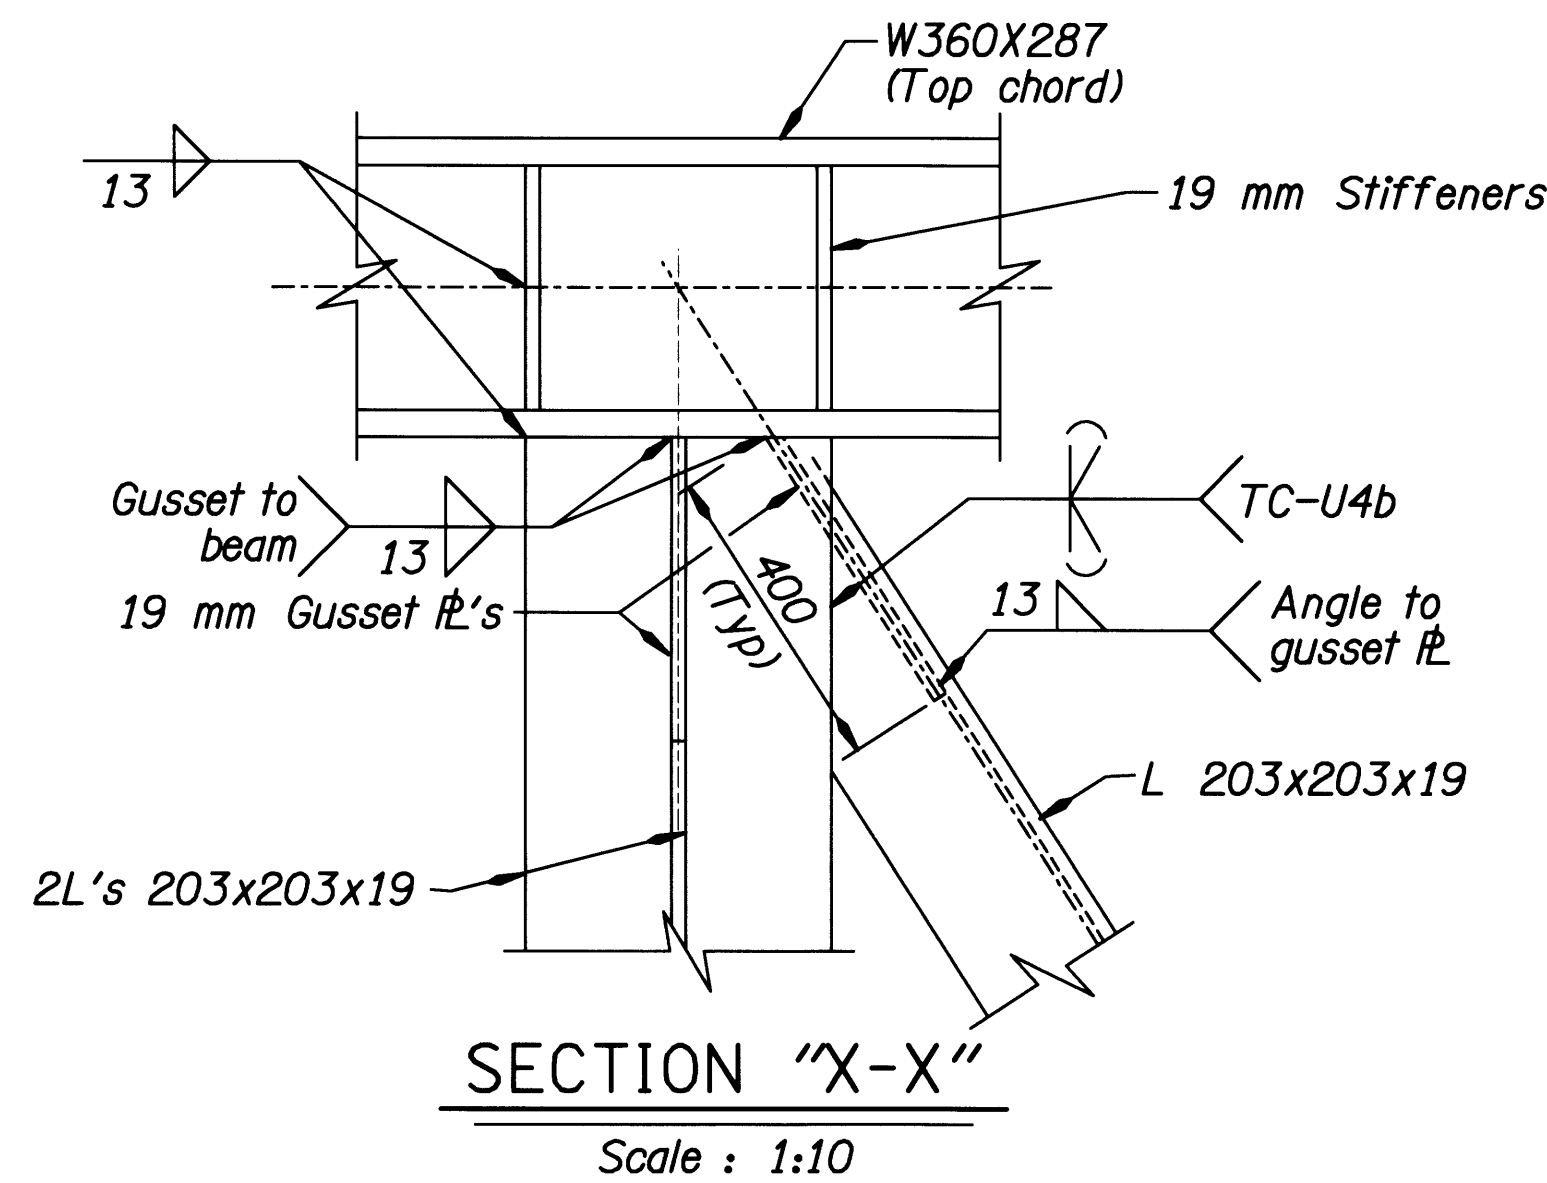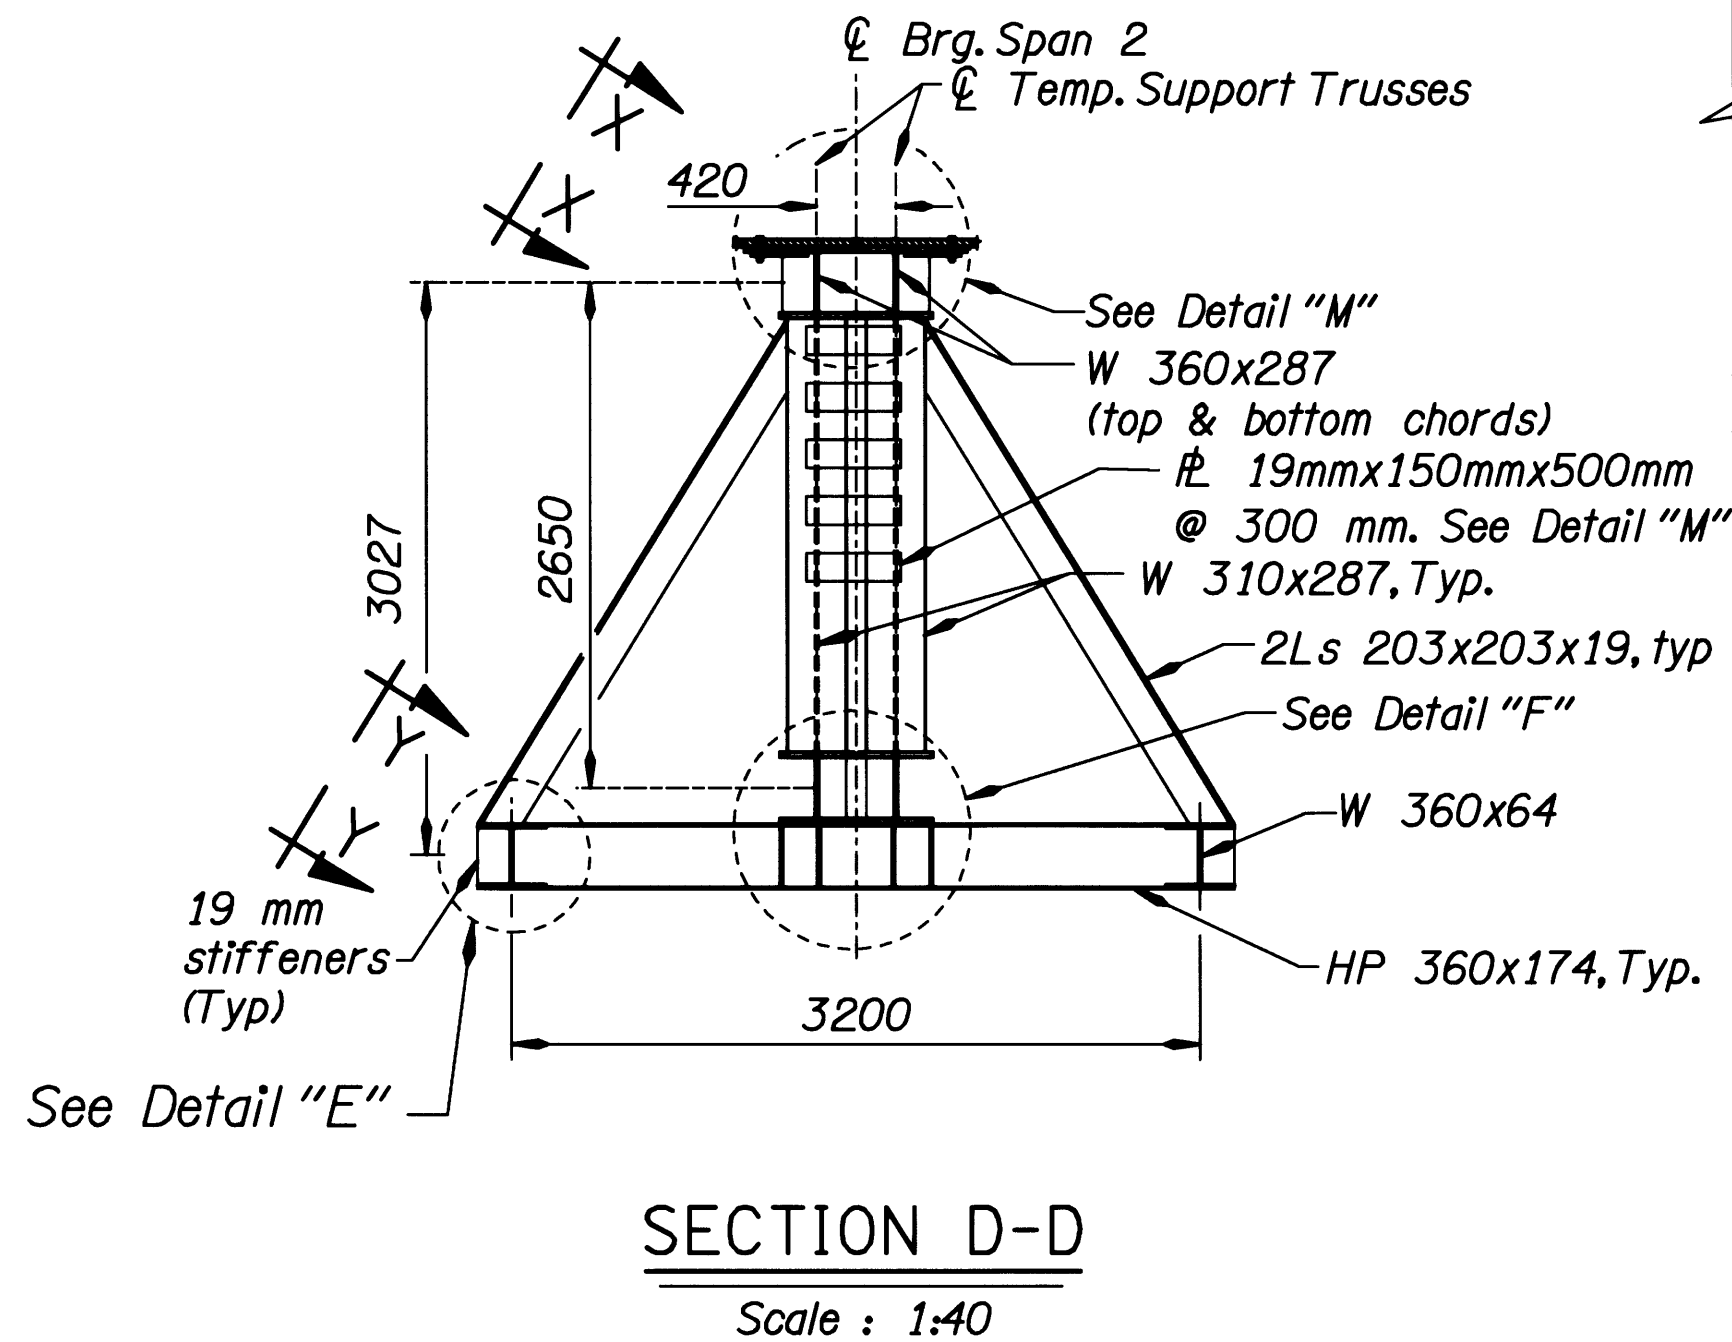
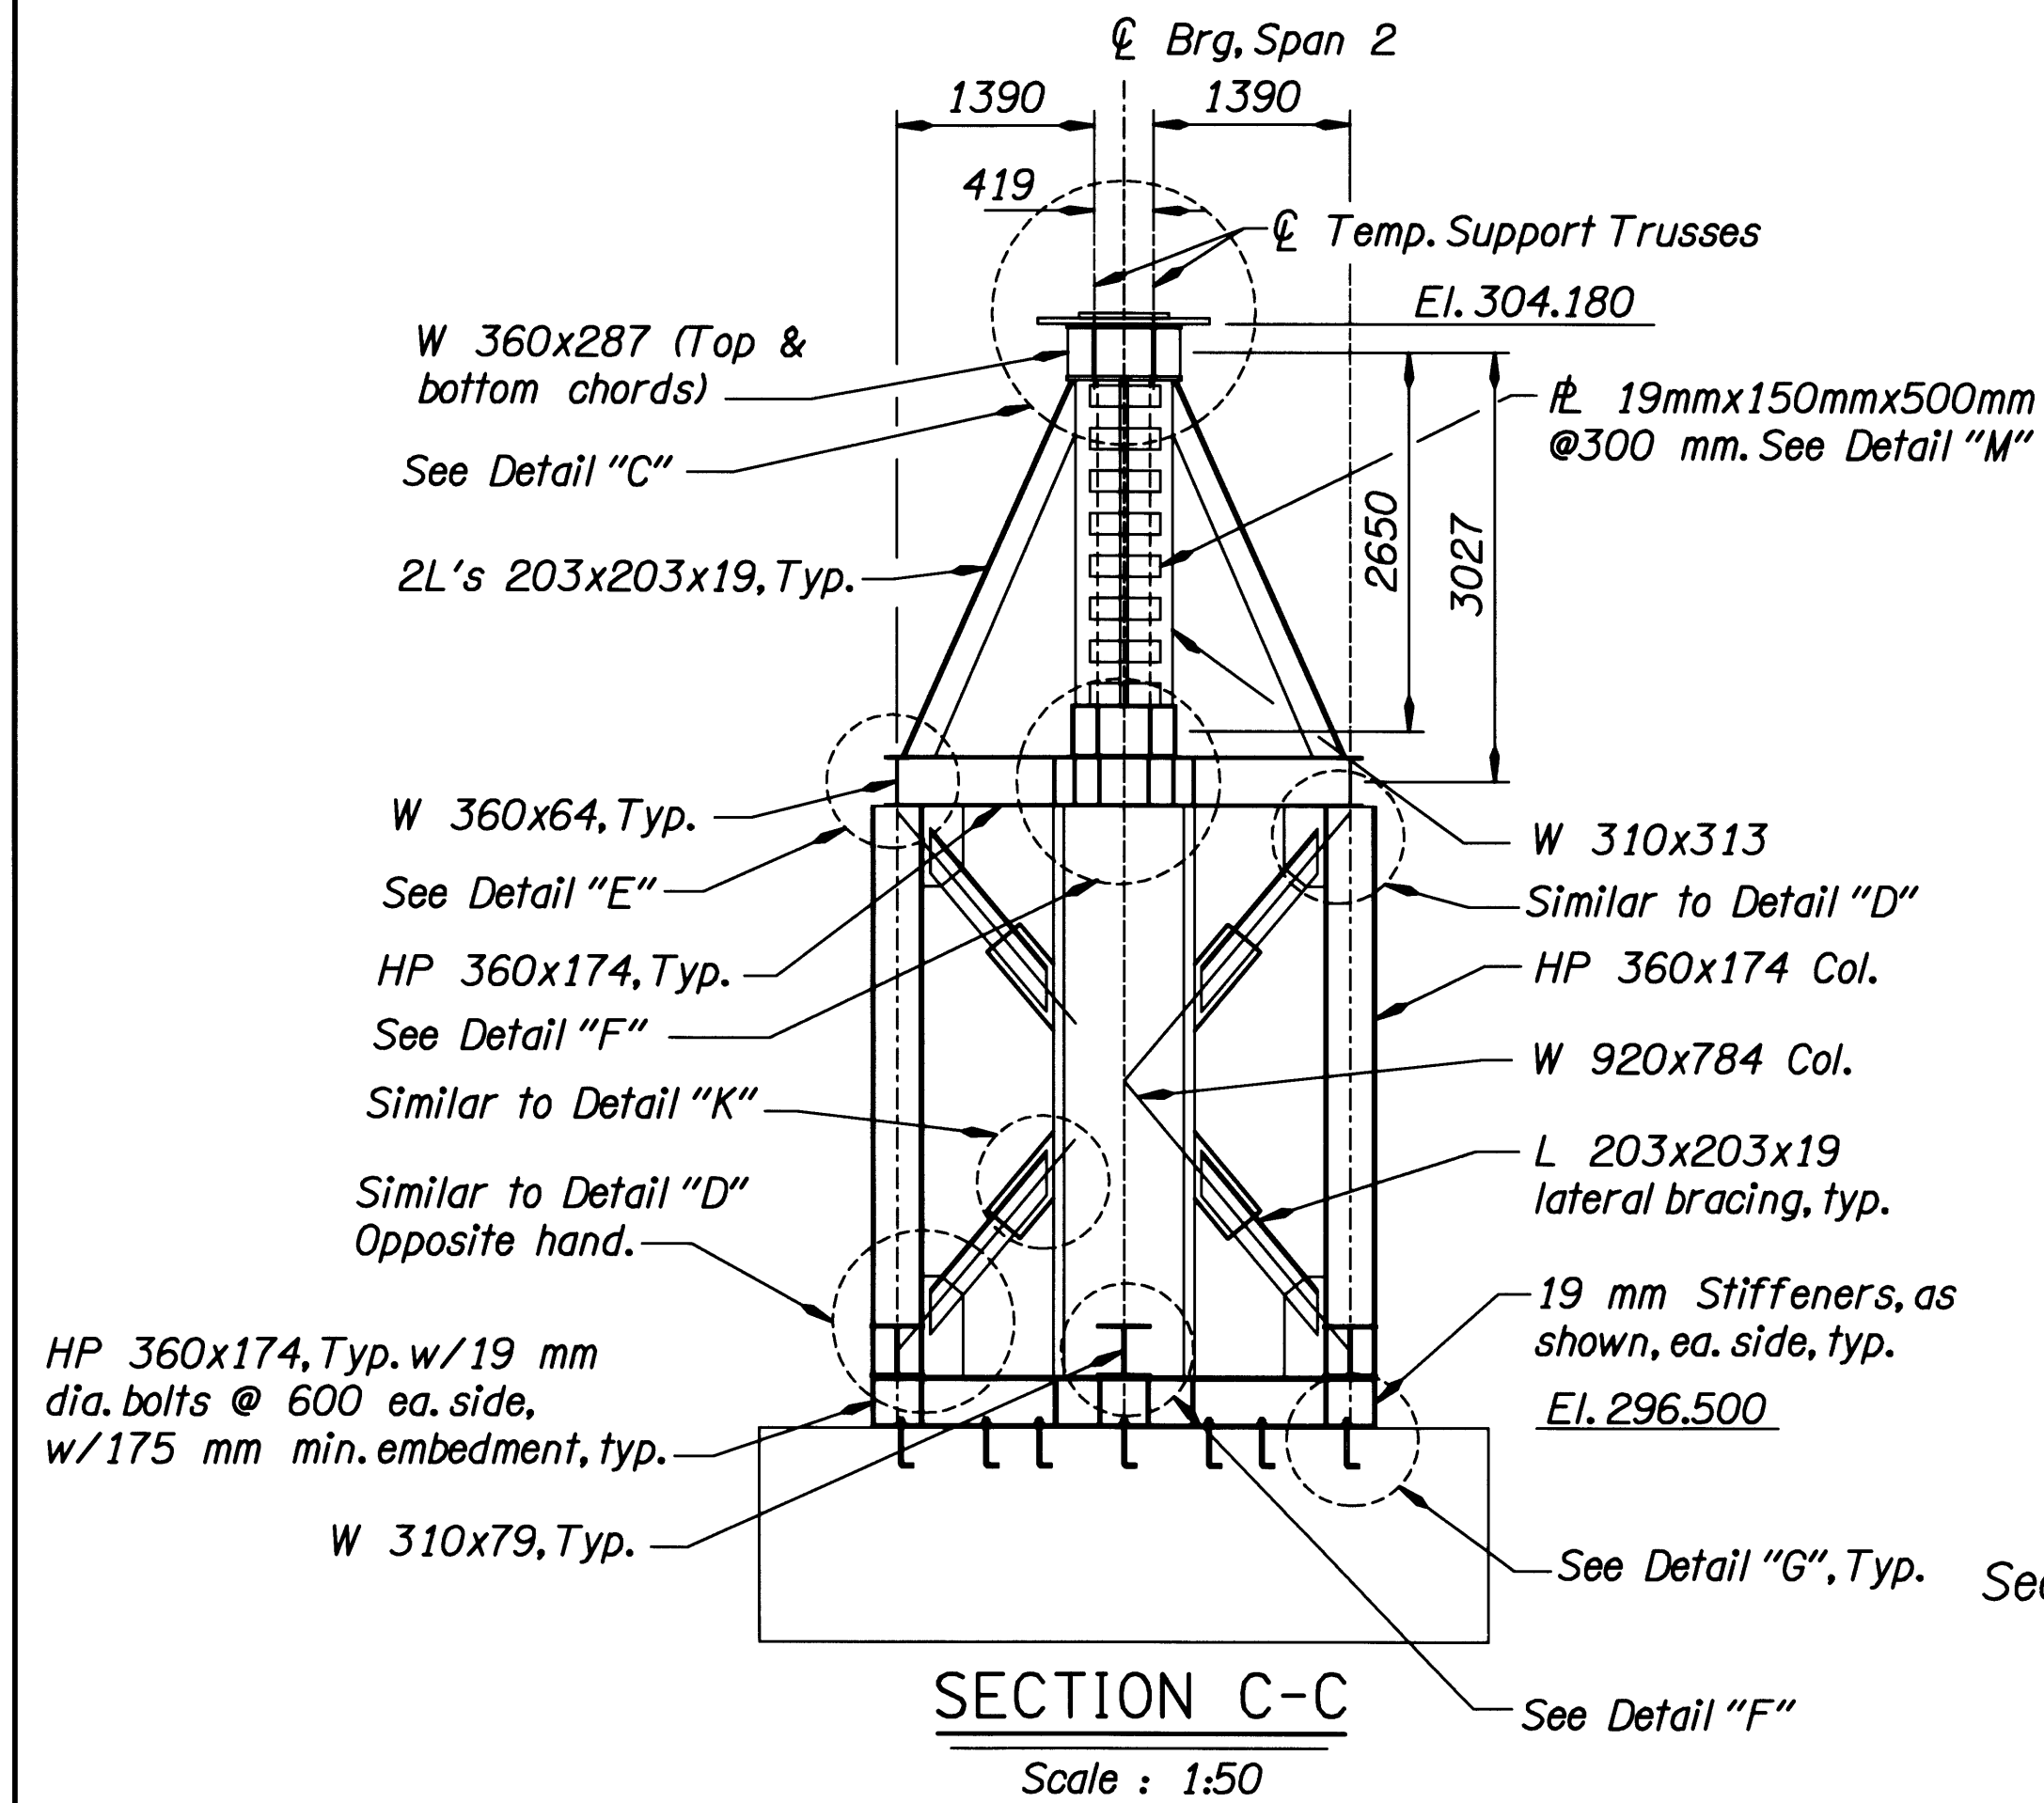


Note:
For section locations, see Dwg. #61780.
For Details "A" thru "F", see Dwg. #61783.
For Details "G" thru "N", see Dwg. #61784.
For Bent 2 Temporary Crossbeam Support Columns, see Dwg. #61726 and #61779.

Note:
All dimensions are in millimeters (mm) and all elevations are meters (m) except as noted.

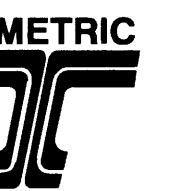


DATE	REVISION	BY	DESIGNER	BRIDGE NO.	DATE	CALC. BOOK	ROGUE RIVER (DEPOT STREET) BRIDGE	SHEET
03/08	AS CONSTRUCTED	AVS	C. Schreiner	19273	Nov. 2002	5081	TEMPORARY SUPPORT TRUSS SECTIONS	64
								OF
								81
								DRAWING NO.
								61782

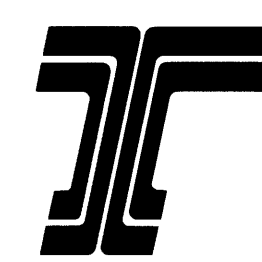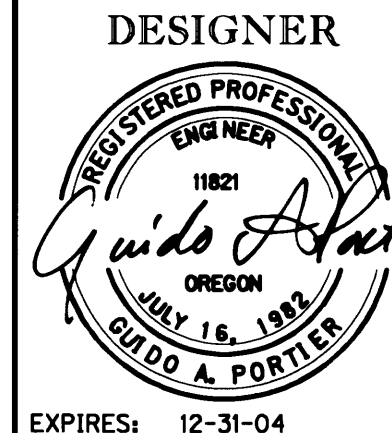


OREGON DEPARTMENT OF TRANSPORTATION
BRIDGE ENGINEERING SECTION

DAVID EVANS
AND ASSOCIATES INC.
530 Center Street N.E., Suite 605
Salem Oregon 97301
Phone: 503.361.8635

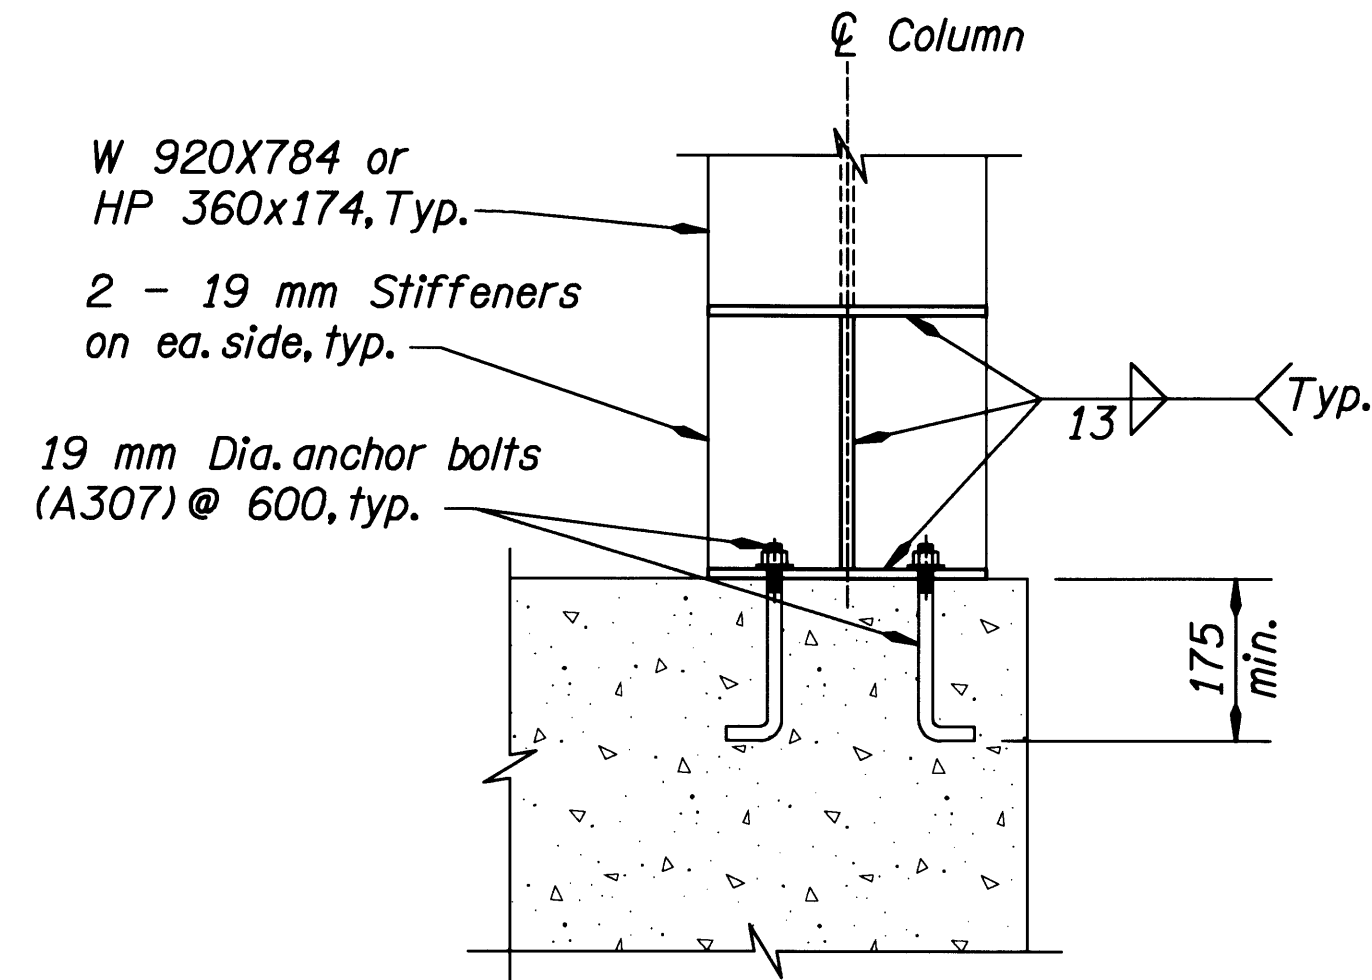


DETAIL "G"
Scale : 1:10

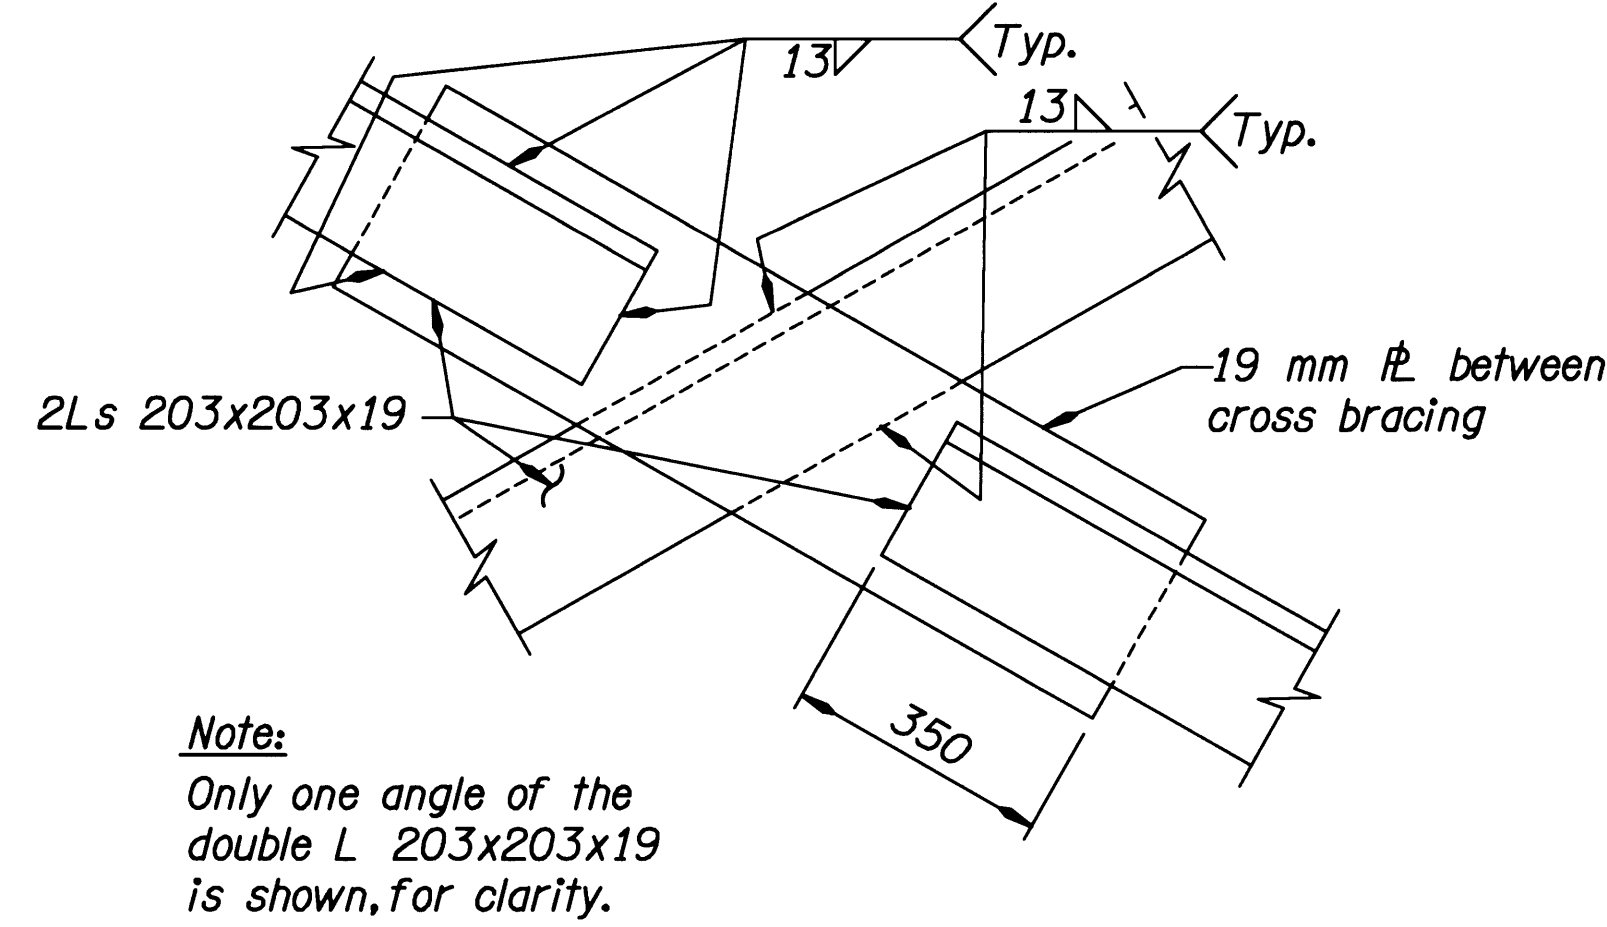


Note:
Only one angle of the
double L 203x203x19
is shown, for clarity.


DETAIL "L"
Scale : 1:10

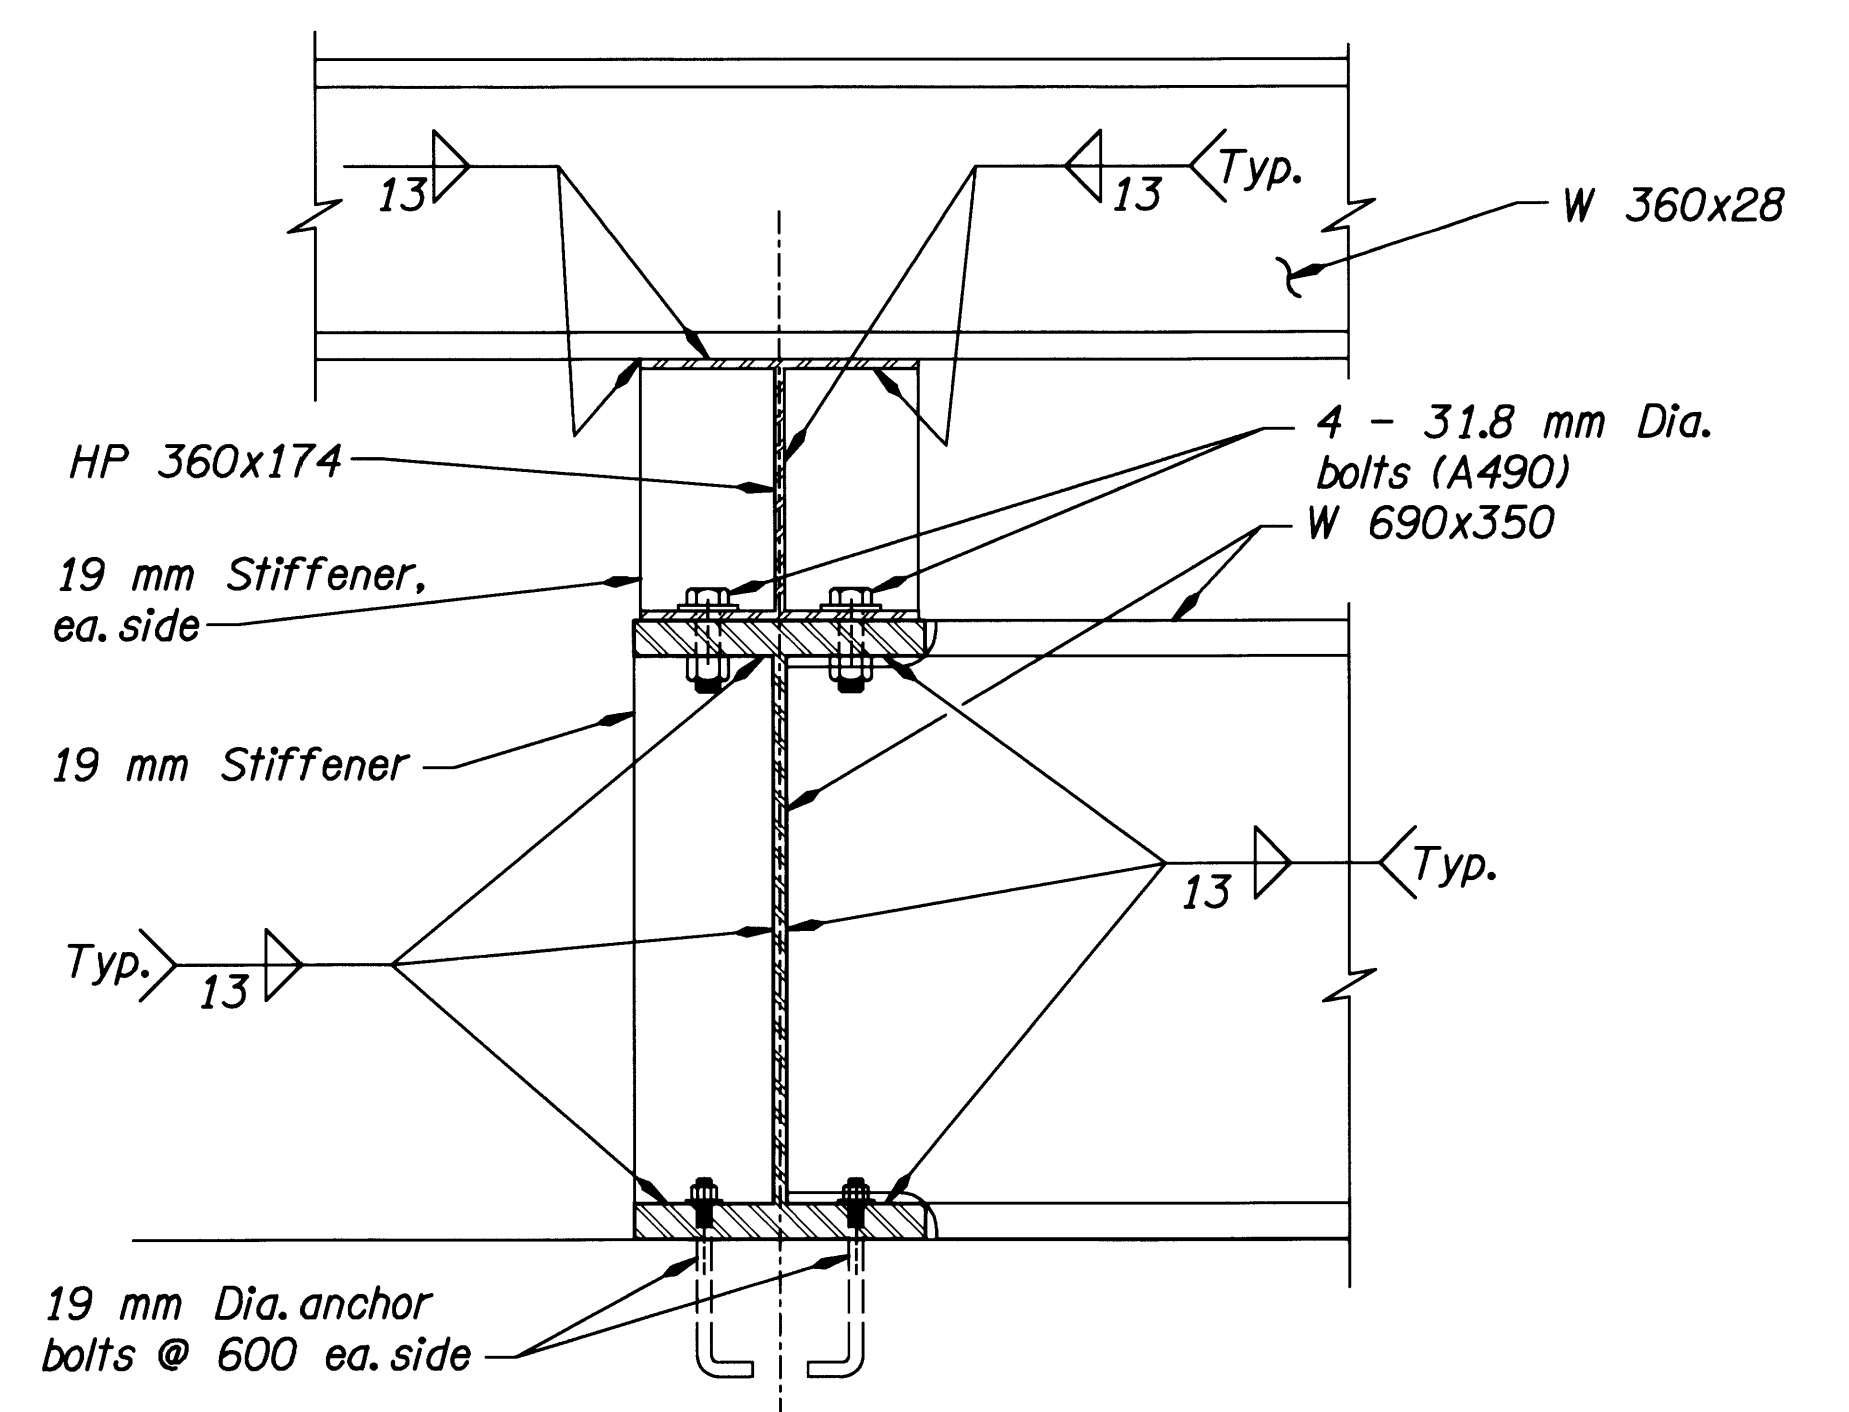


DETAIL "N"
Scale : 1:10

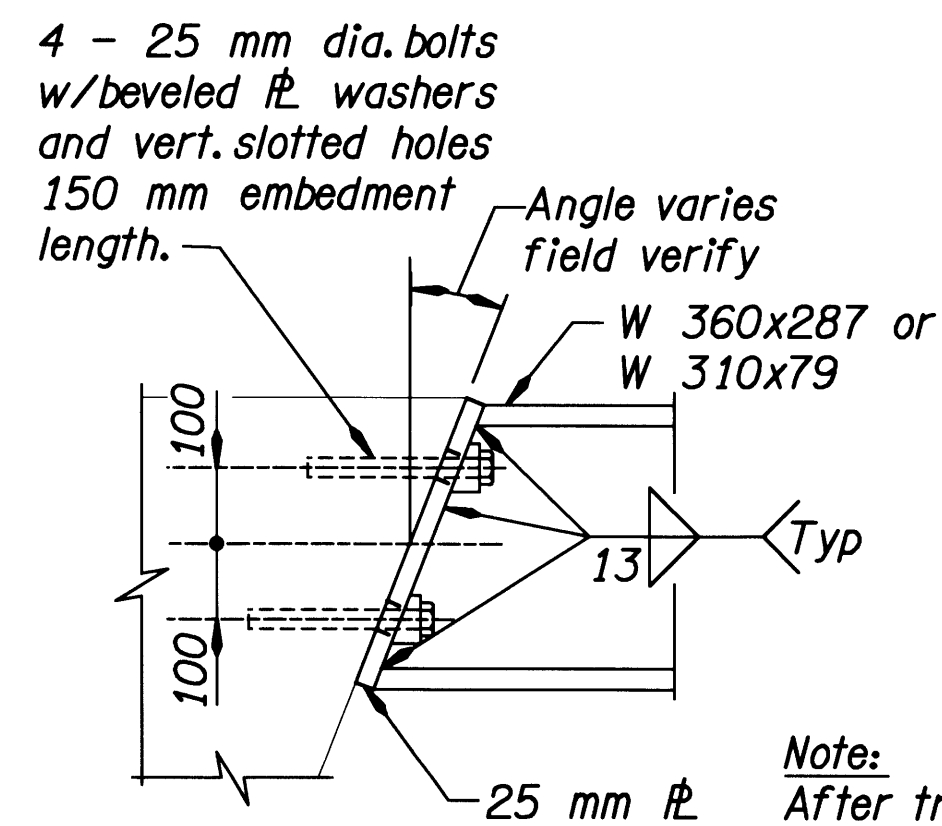

DETAIL "H"
Scale : 1:10

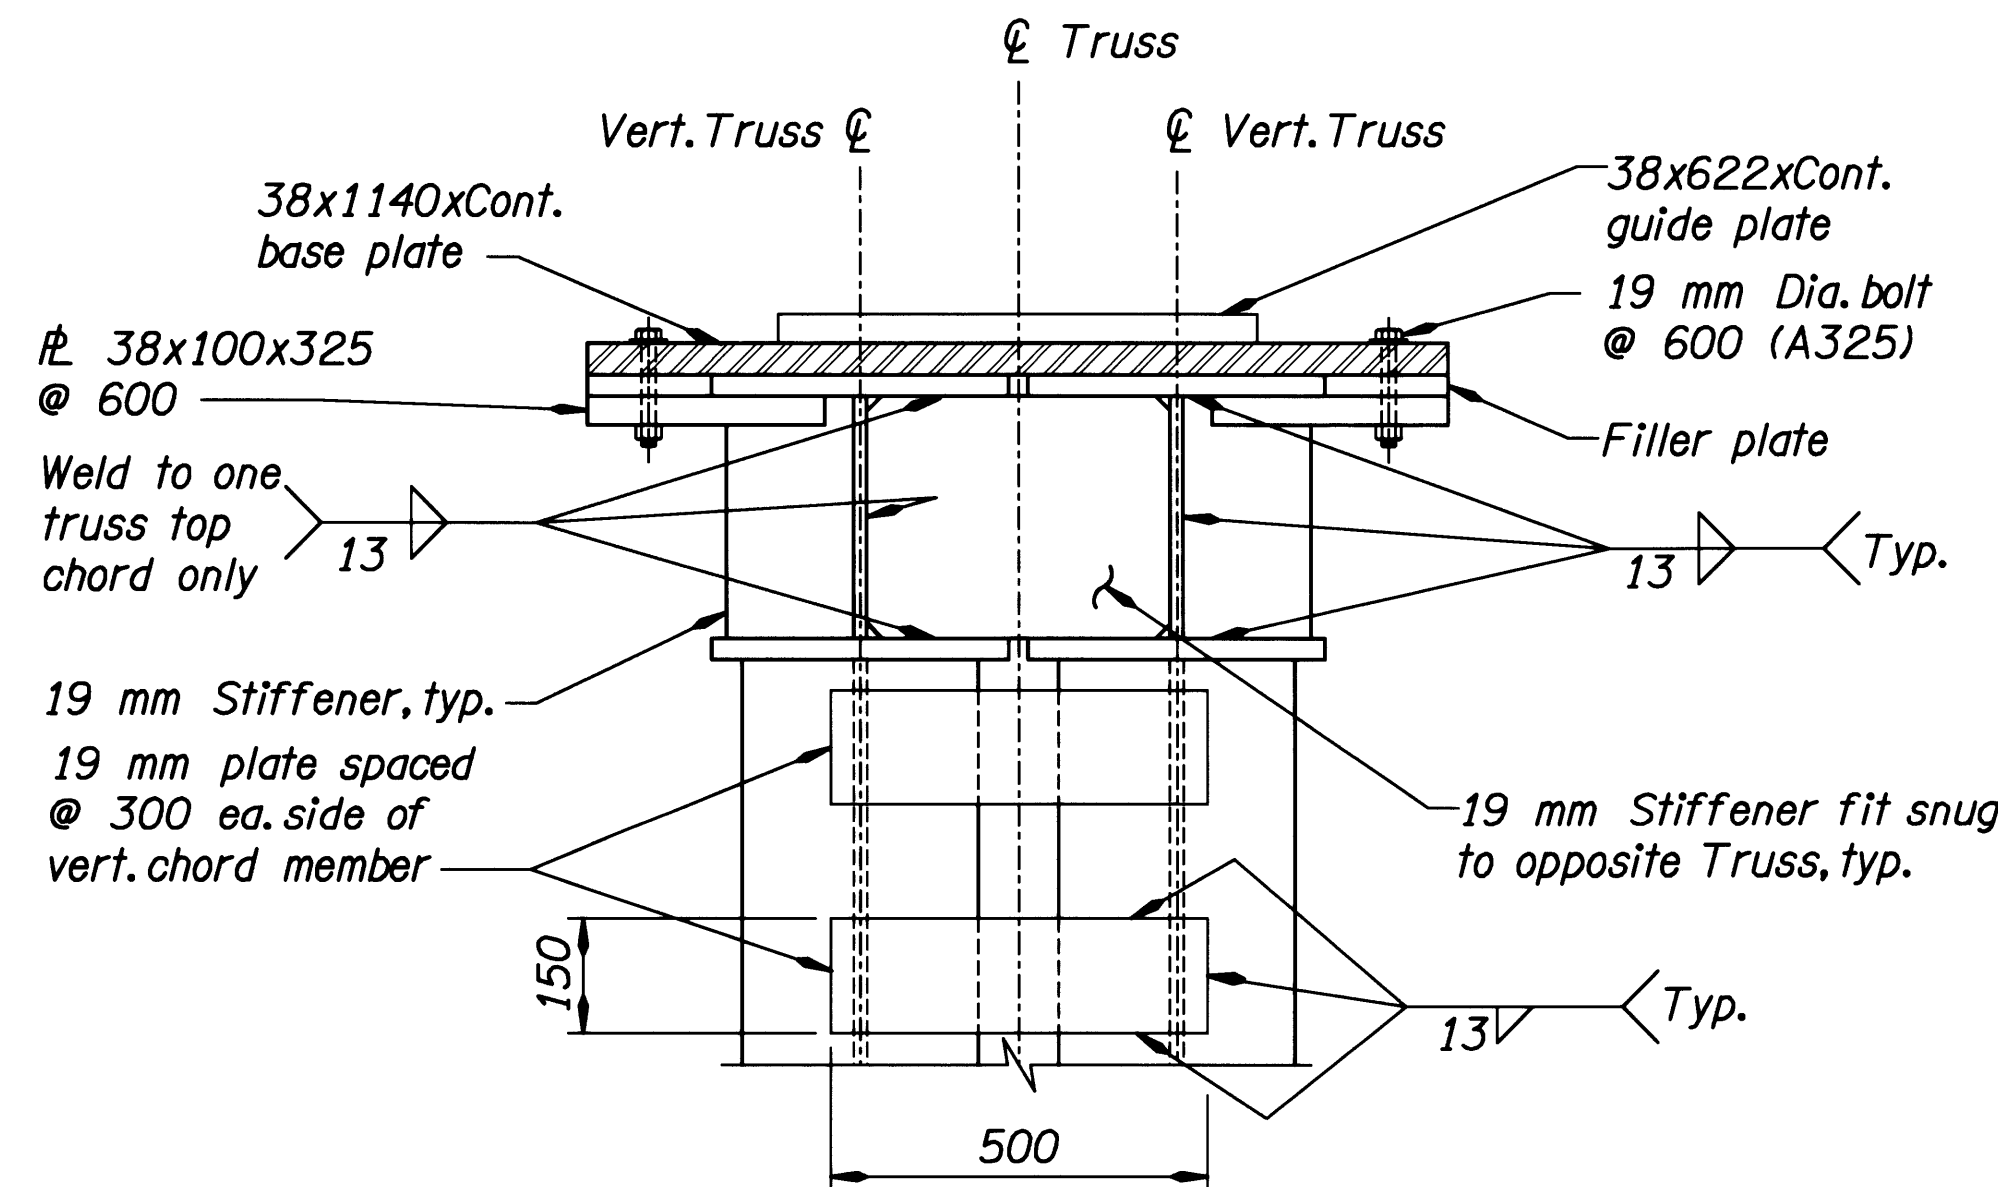


DETAIL "M"
Scale : 1:10

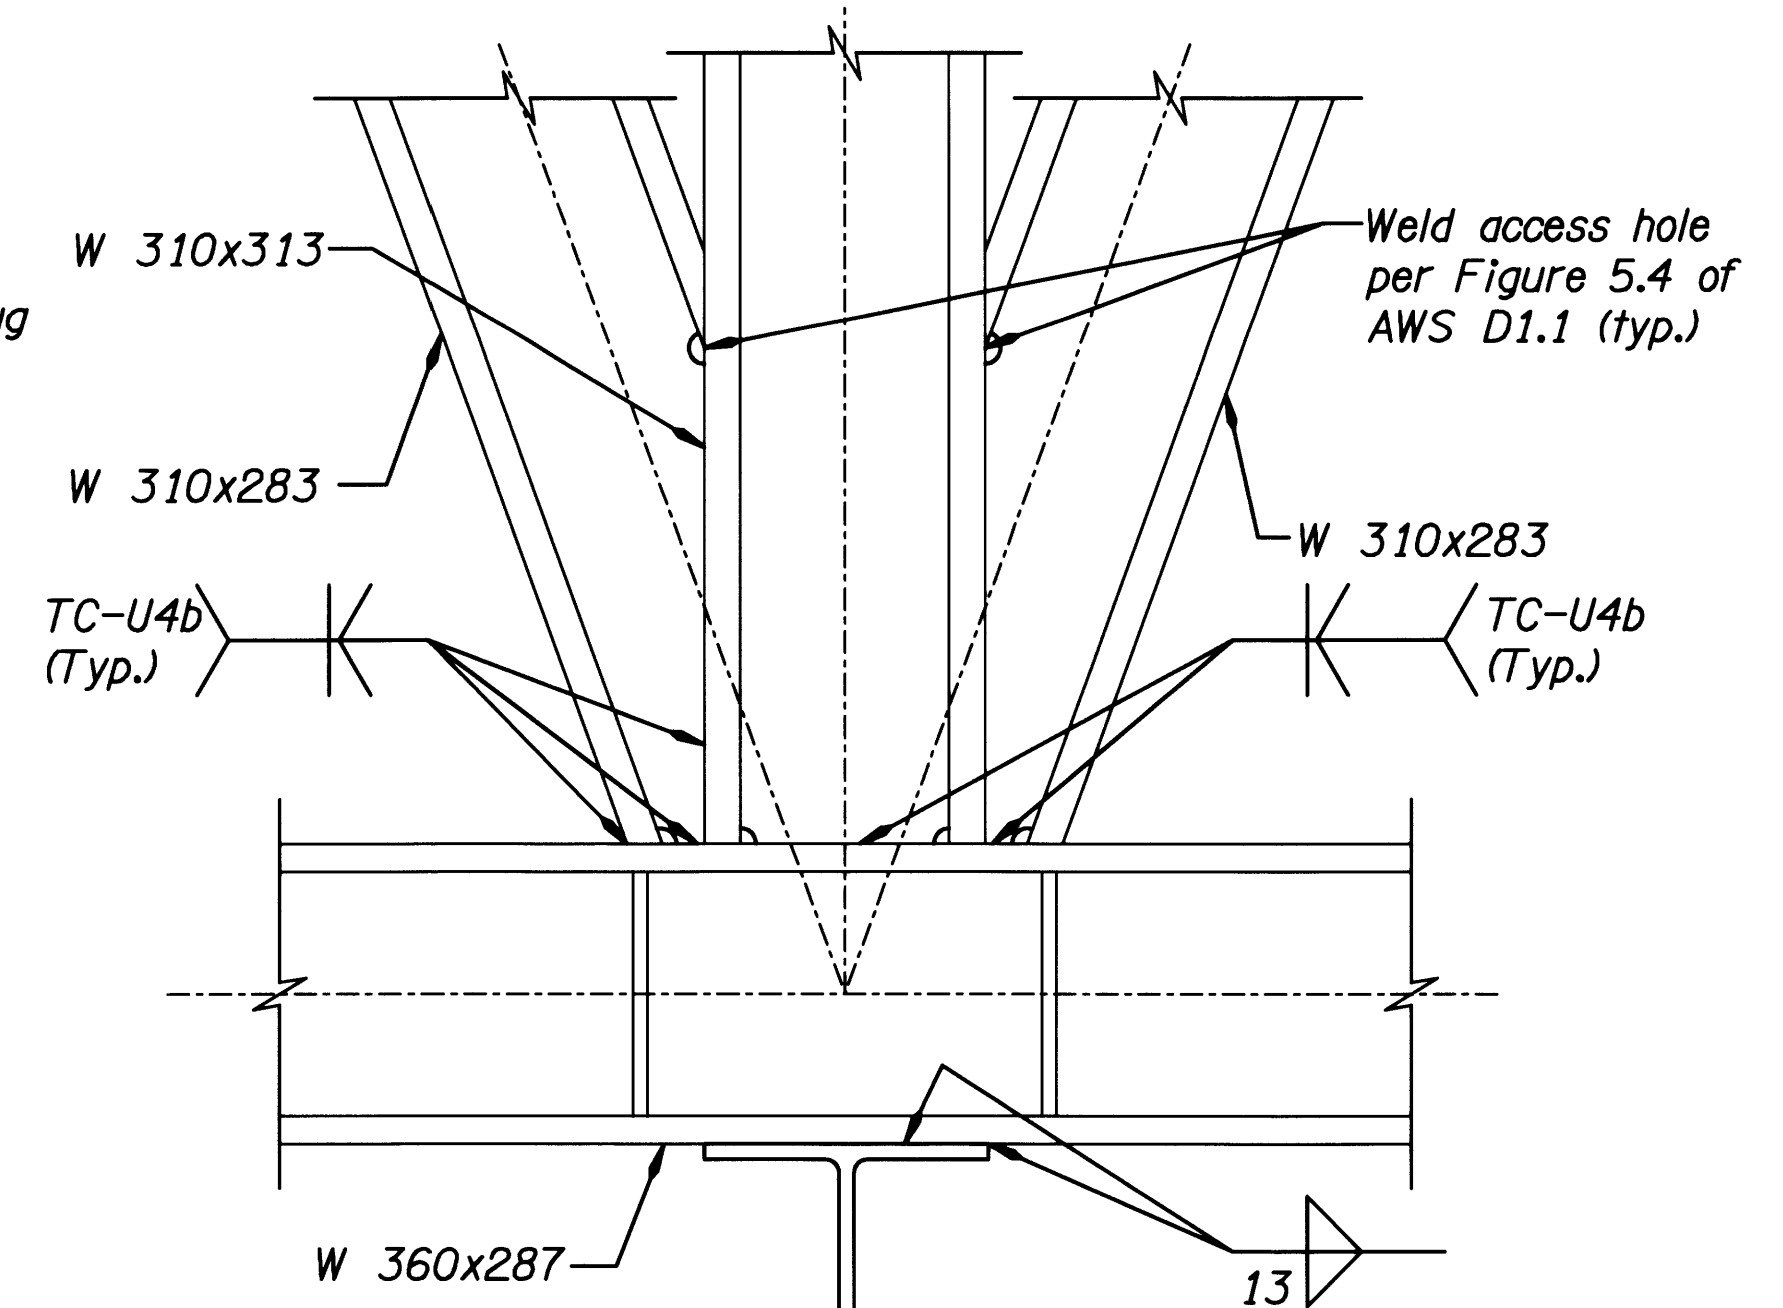


DETAIL "P"
Scale : 1:10

Note:
For Detail locations, see Dwgs
#61780, #61781, & #61783

Note:
All dimensions are in millimeters (mm) and
all elevations are meters (m) except as noted.

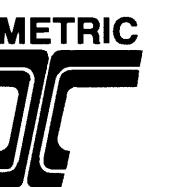


DATE	REVISION	BY	DESIGNER	BRIDGE NO.	ROGUE RIVER (DEPOT STREET) BRIDGE	SHEET
03/08	AS CONSTRUCTED	AVS	C. Schreiner	19273		66
				DATE		OF
				Nov. 2002		81
				CALC. BOOK	TEMPORARY SUPPORT TRUSS DETAILS	DRAWING NO.
				5081		61784

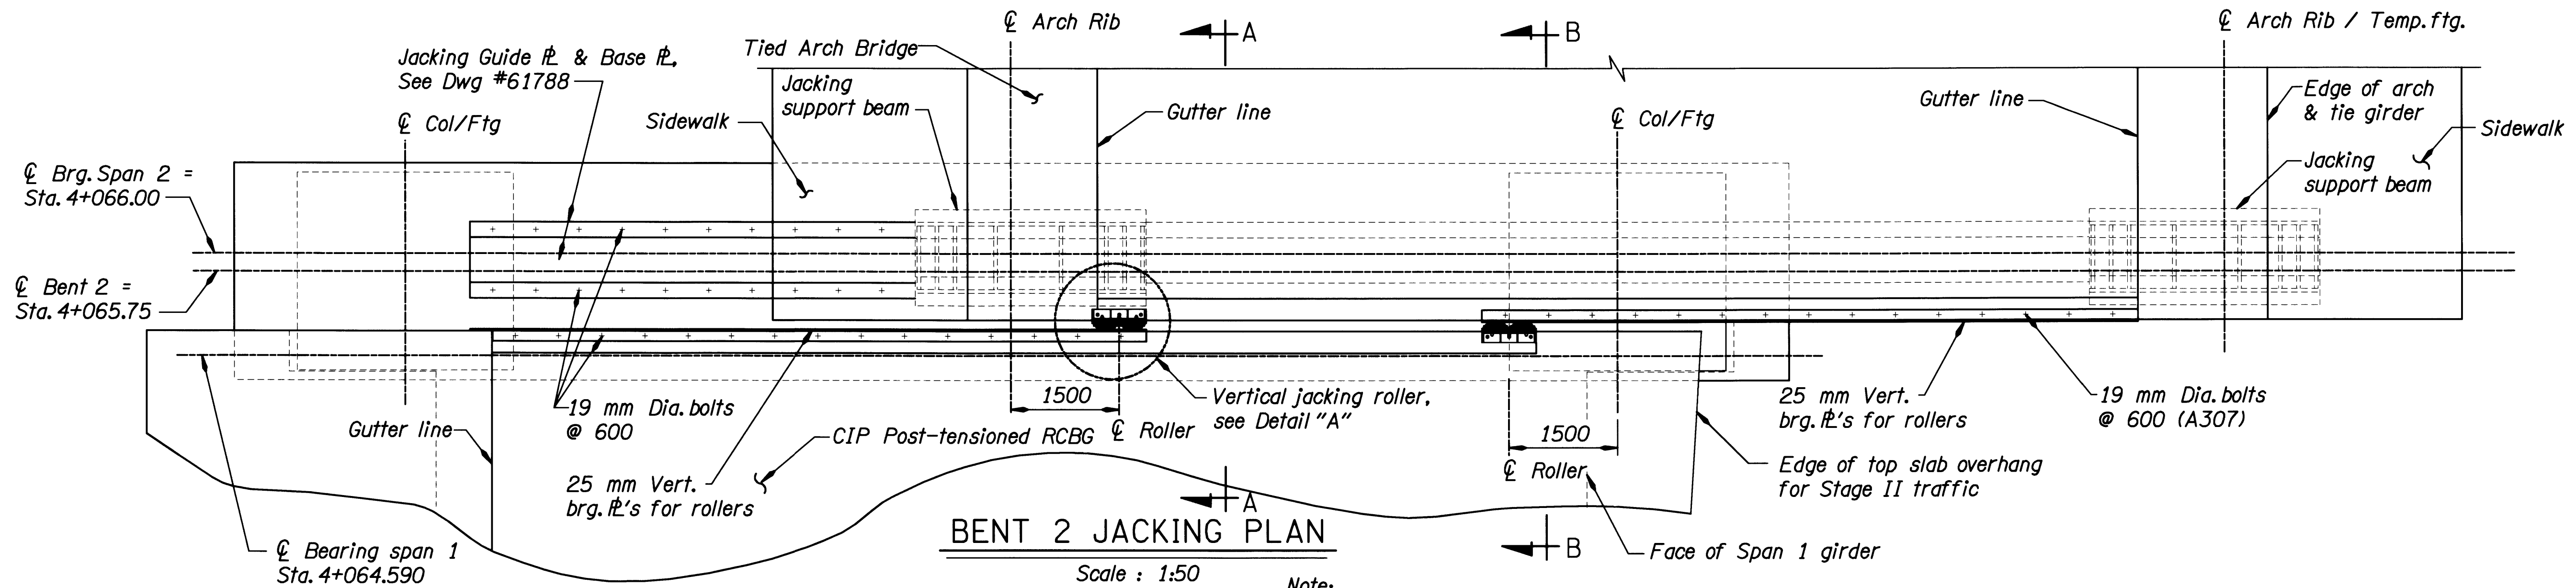

Note:


1. For Section "A-A" & "B-B", see Dwg #61786.
2. For Bearing Staging Sequence, see Dwg #61787.
3. For Jacking Support Beam Detail, see Dwg #61767.
4. For Jacking Force Diagram, see Dwg #61779

Connection for jacking to bridge using P/T strands, high strength threaded bar or cables by contractor. See Dwg #61779 for loading requirements, Bent 3 is similar.

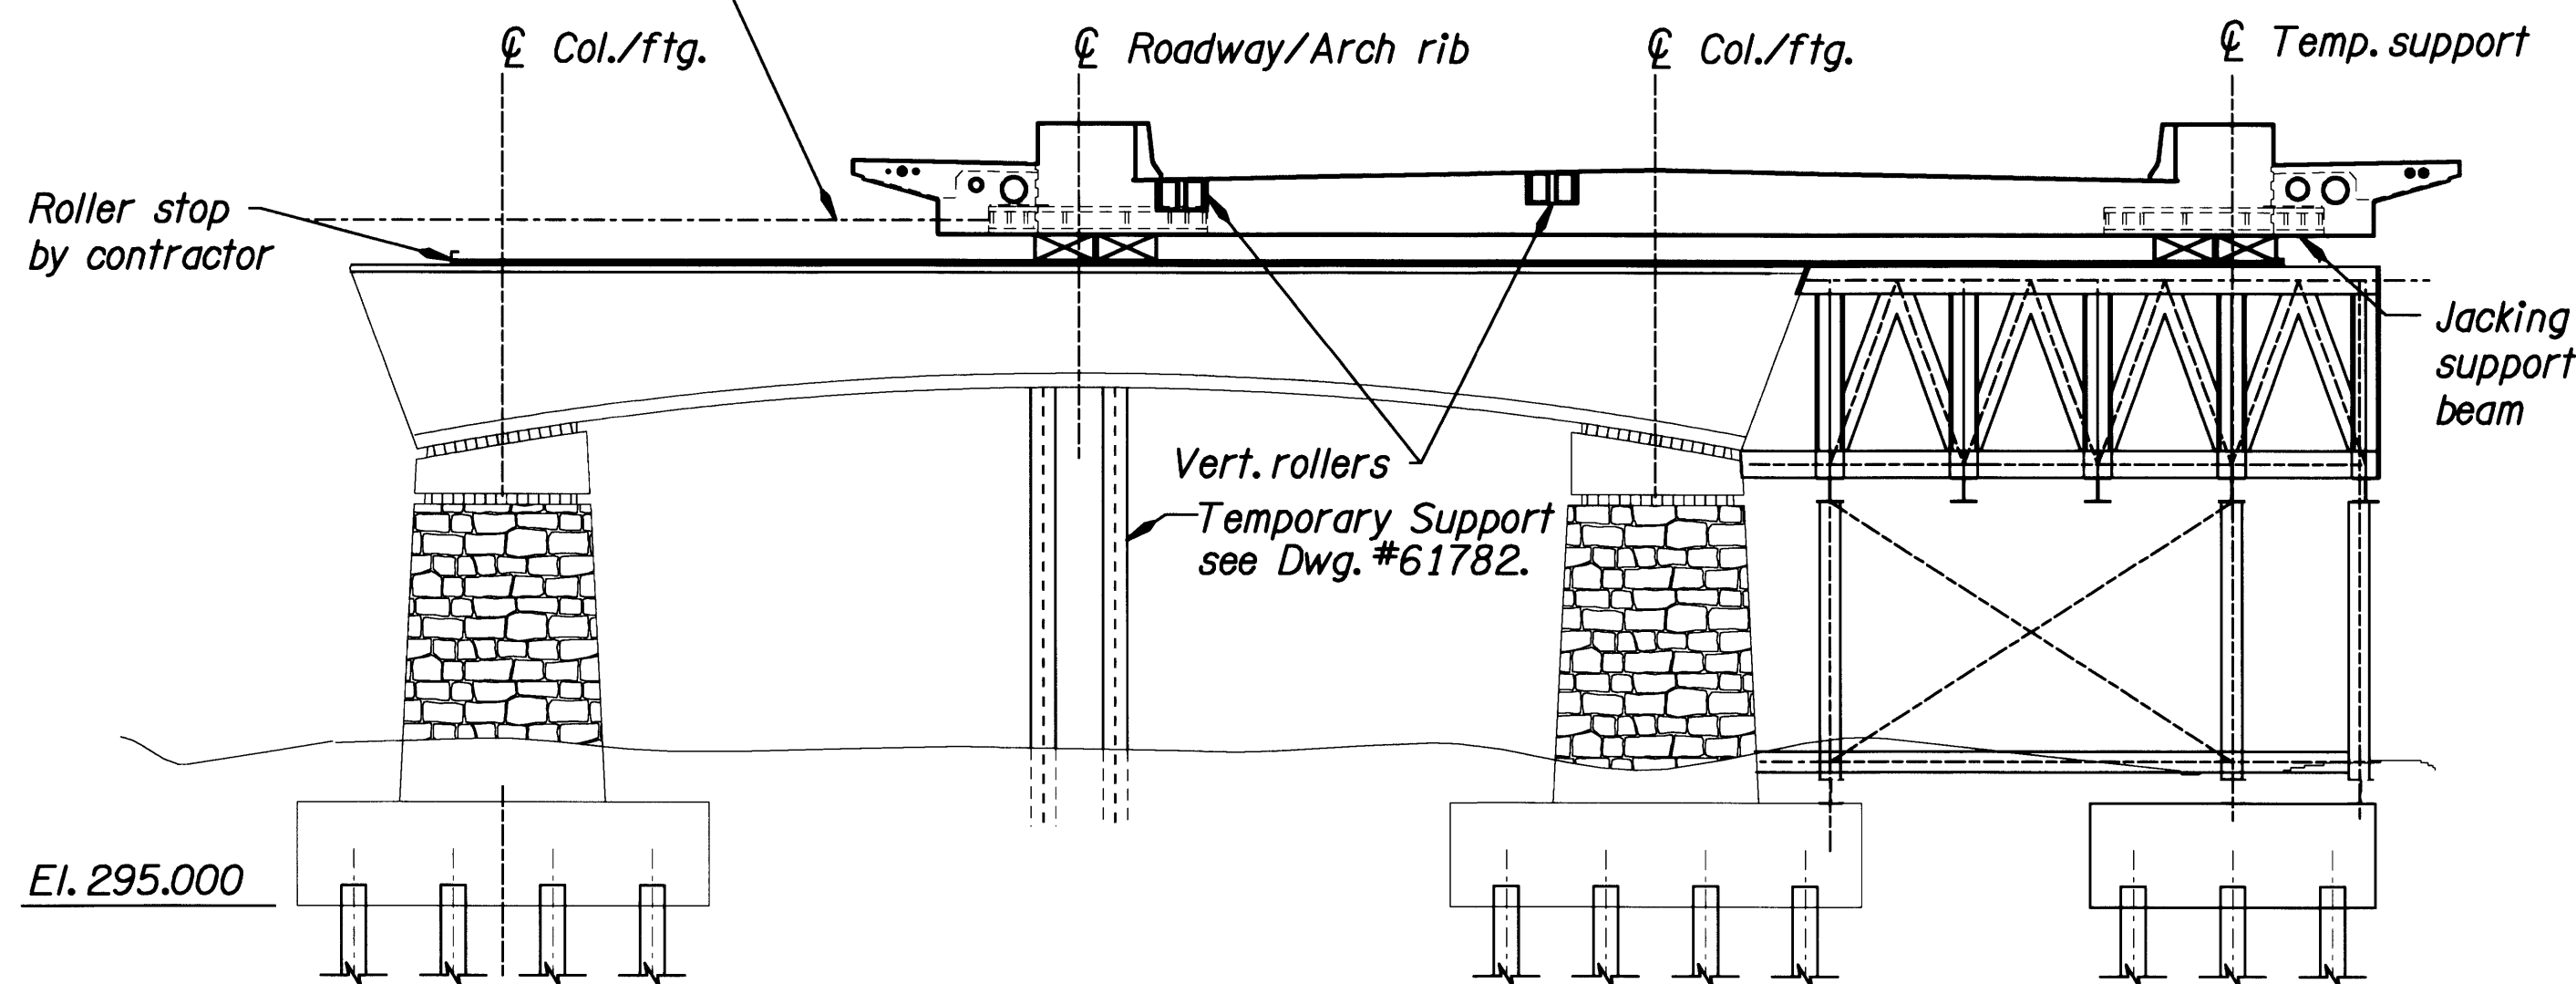

JACKING INTO FINAL ALIGNMENT (BENT 2 SHOWN)


Scale : 1:100

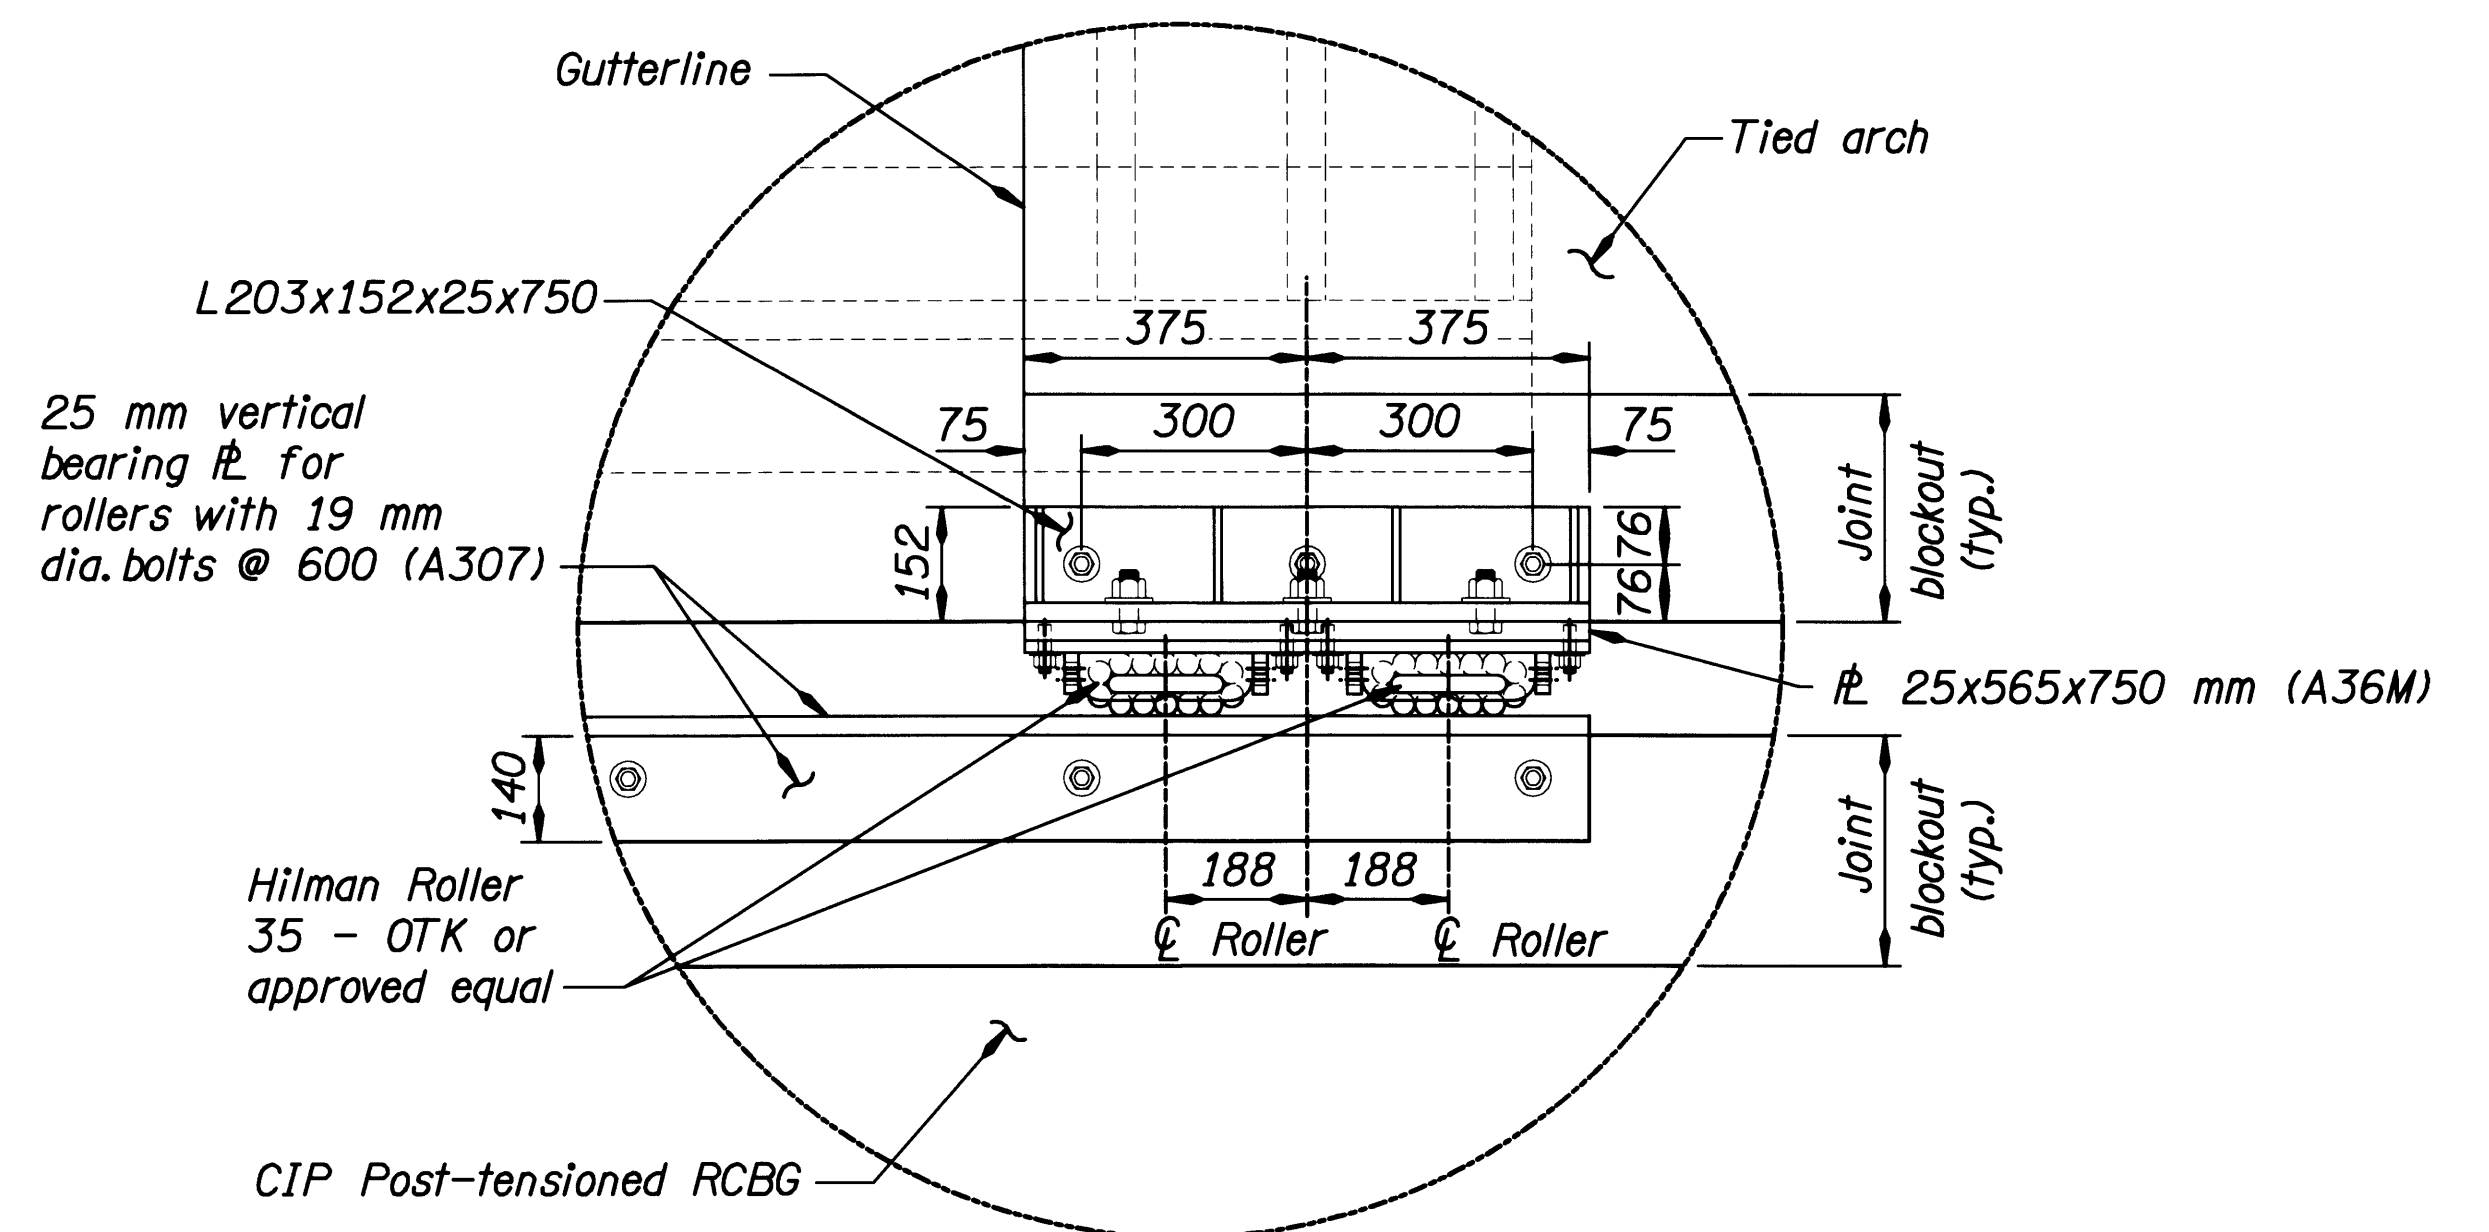



DETAIL "A"

Scale : 1:10

Note:
All dimensions are in millimeters (mm) and
all elevations are meters (m) except as noted.

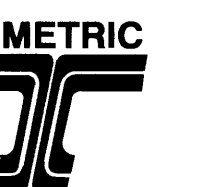


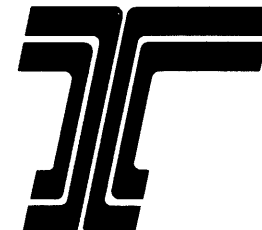A	DATE	REVISION	BY	R. Stone	DESIGNER	 OREGON DEPARTMENT OF TRANSPORTATION BRIDGE ENGINEERING SECTION	BRIDGE NO.	ROGUE RIVER (DEPOT STREET) BRIDGE	SHEET
	03/08	AS CONSTRUCTED	AVS	DRAFTED:	 DAVID EVANS AND ASSOCIATES INC. 530 Center Street N.E., Suite 605 Salem Oregon 97301 Phone: 503.361.8635		19273		67
				CHECKED: <i>Bent Cordtz</i> Kent Cordtz			DATE		OF
				REVIEWED: <i>Terry Shike</i> Terry Shike			Nov. 2002		81
					EXPIRES: 12-31-04		CALC. BOOK 5081		DRAWING NO. 61785

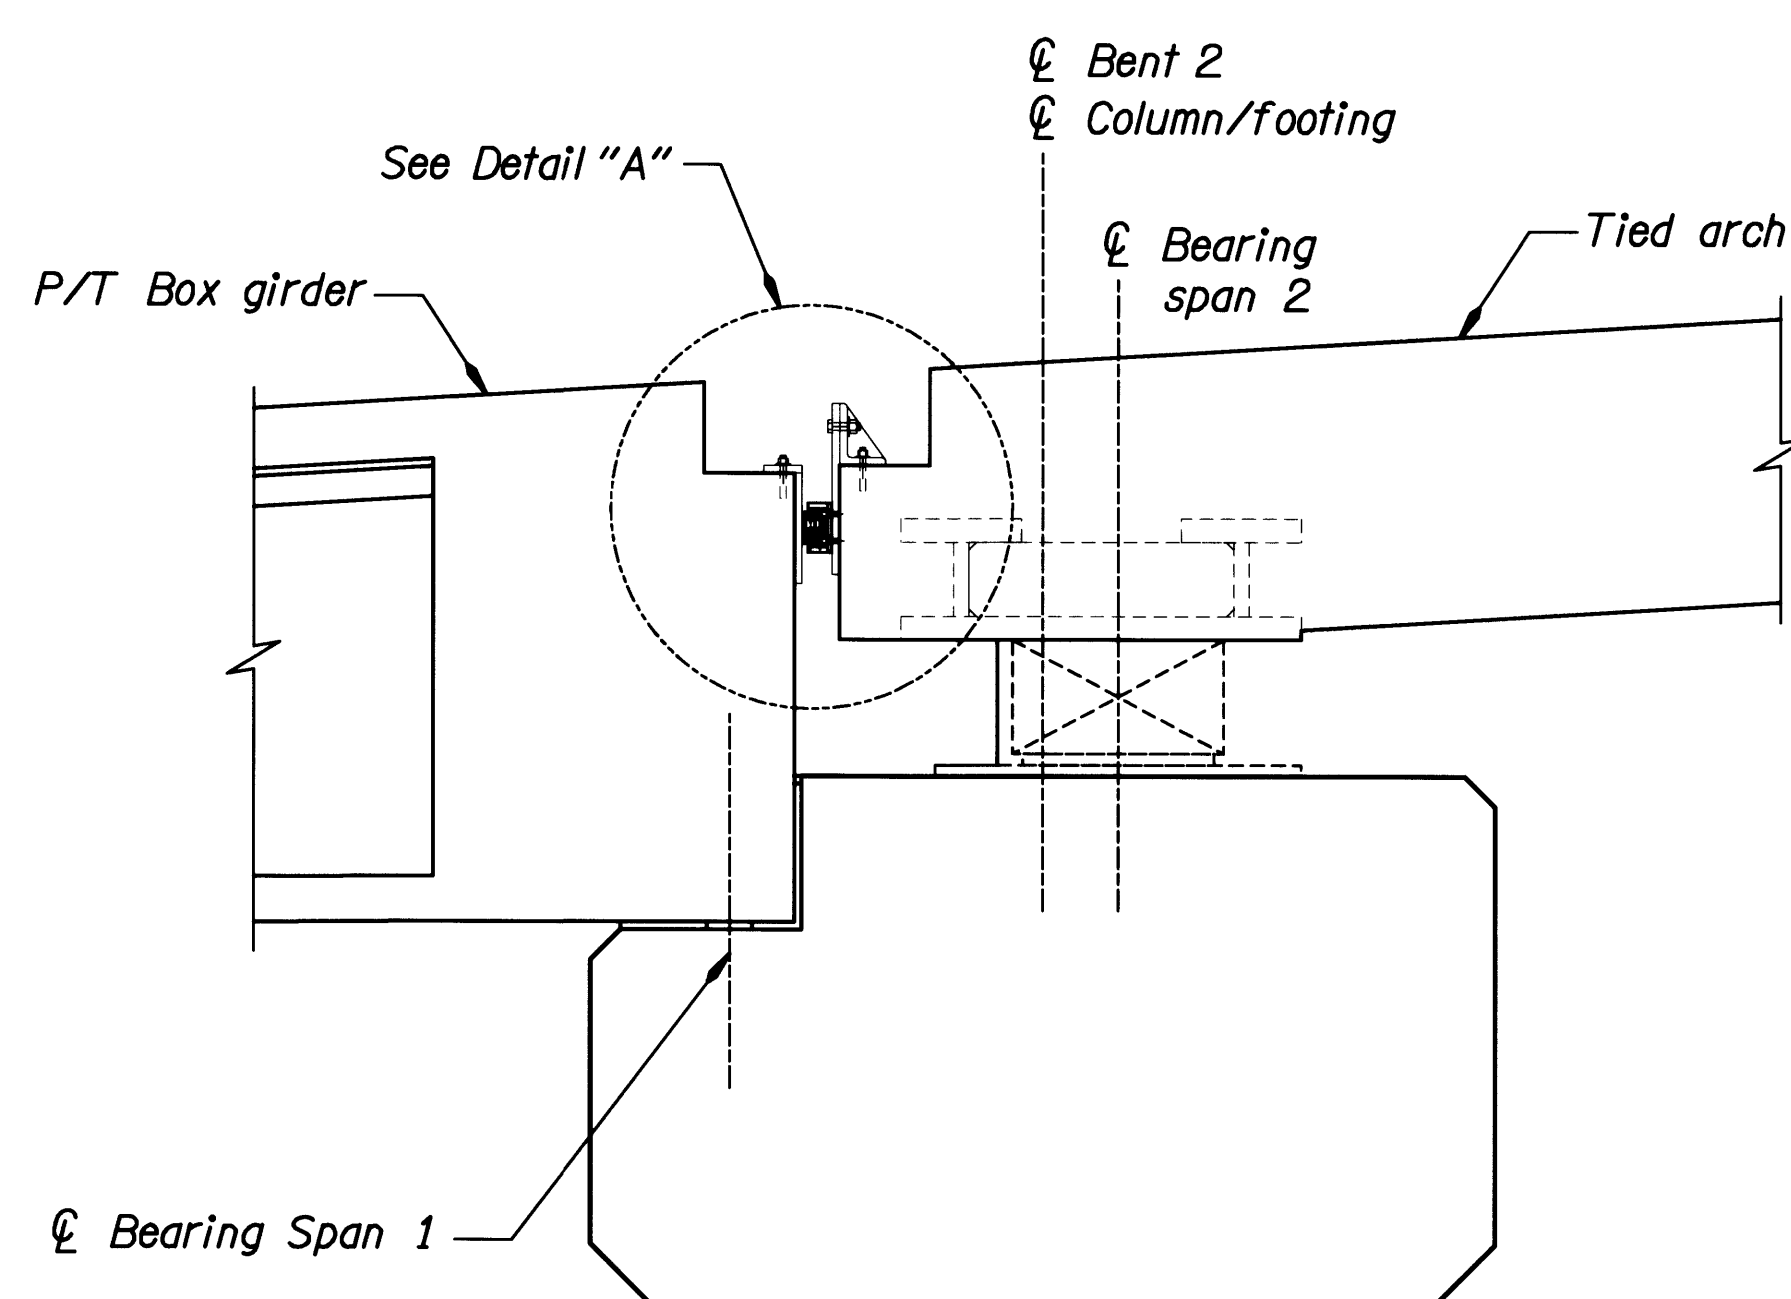


SECTION A-A
ROLLER DETAIL AT TIED ARCH

Scale : 1:25

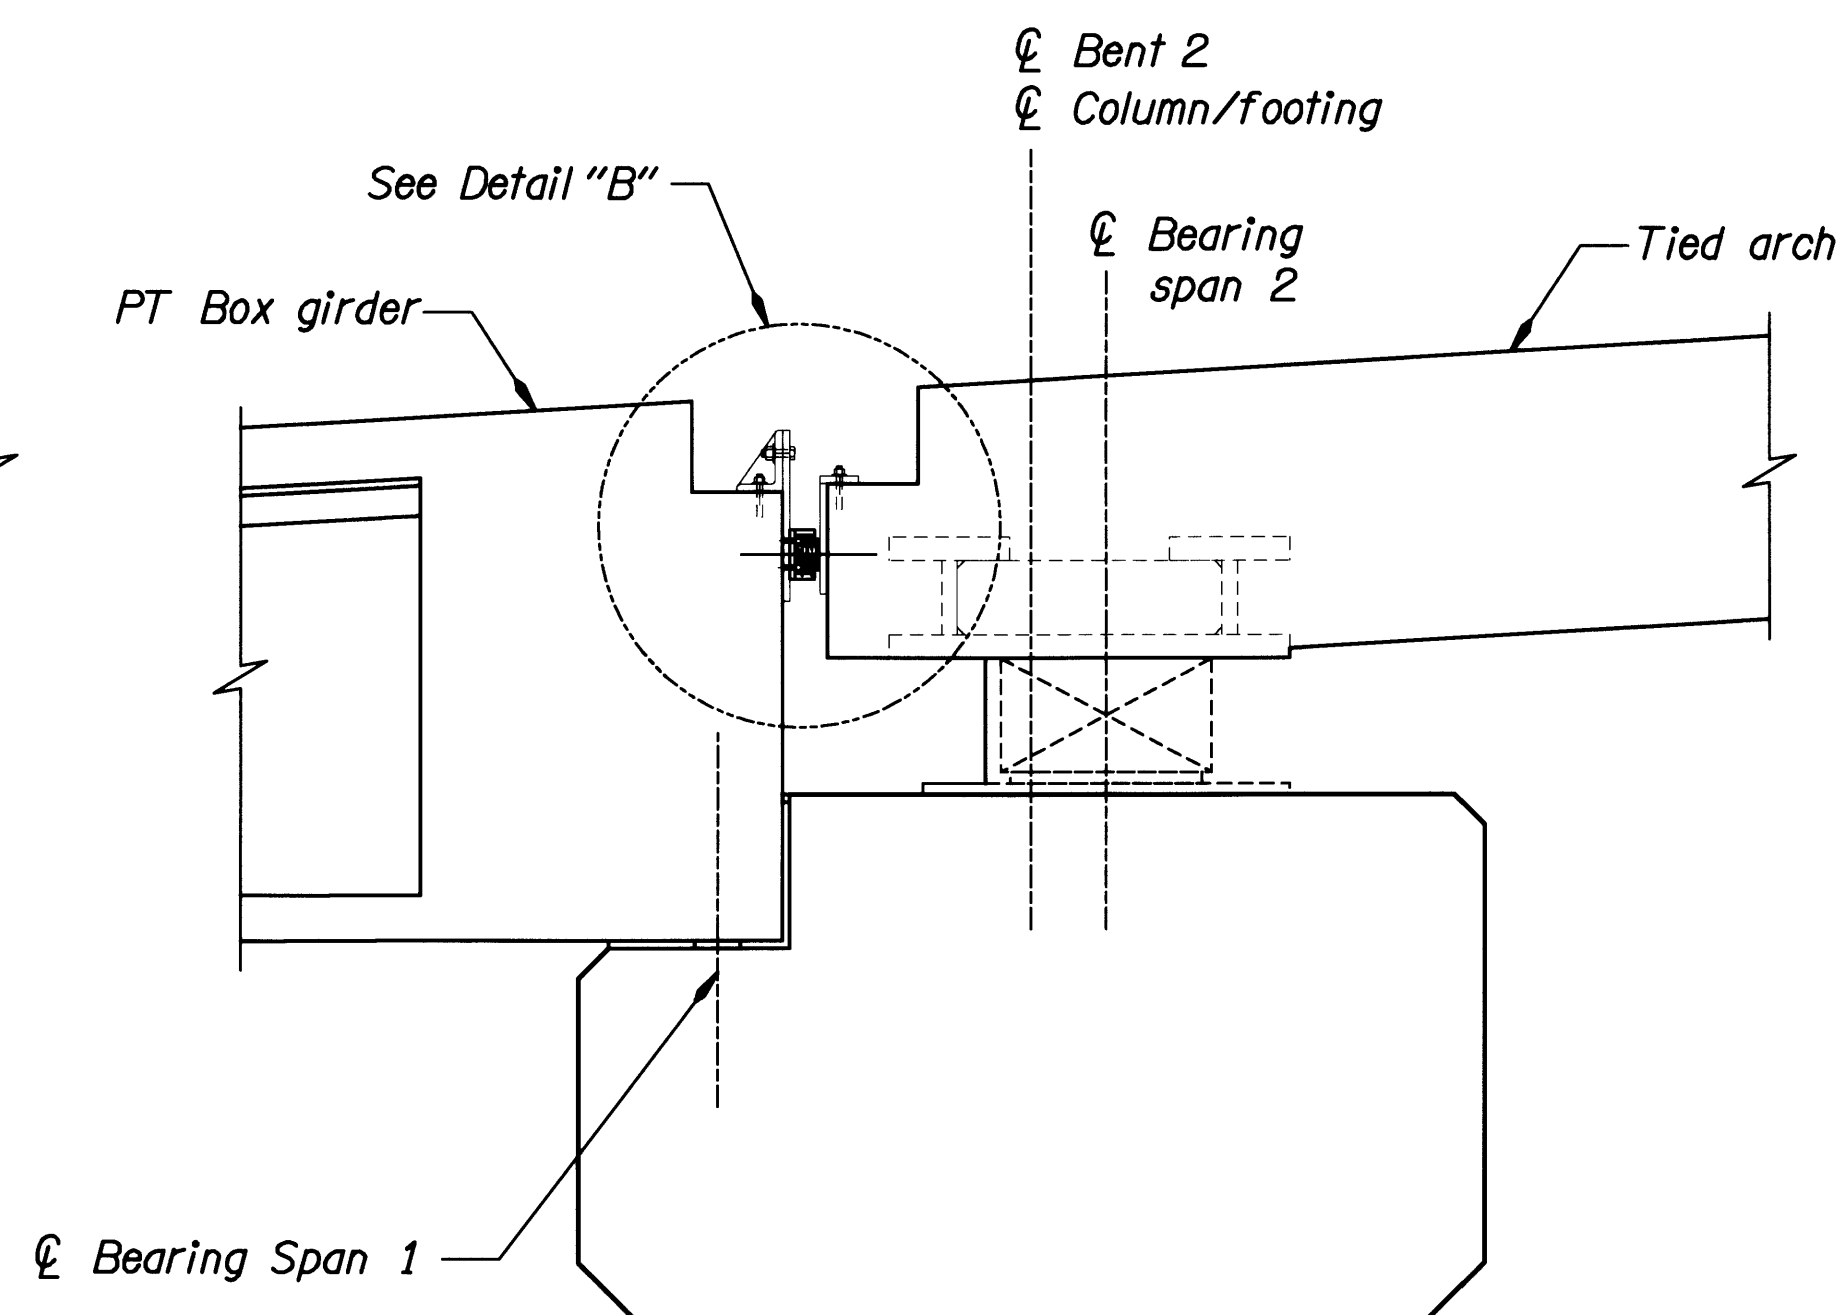


SECTION B-B
ROLLER DETAIL AT P/T BOX GIRDER

Scale : 1:25

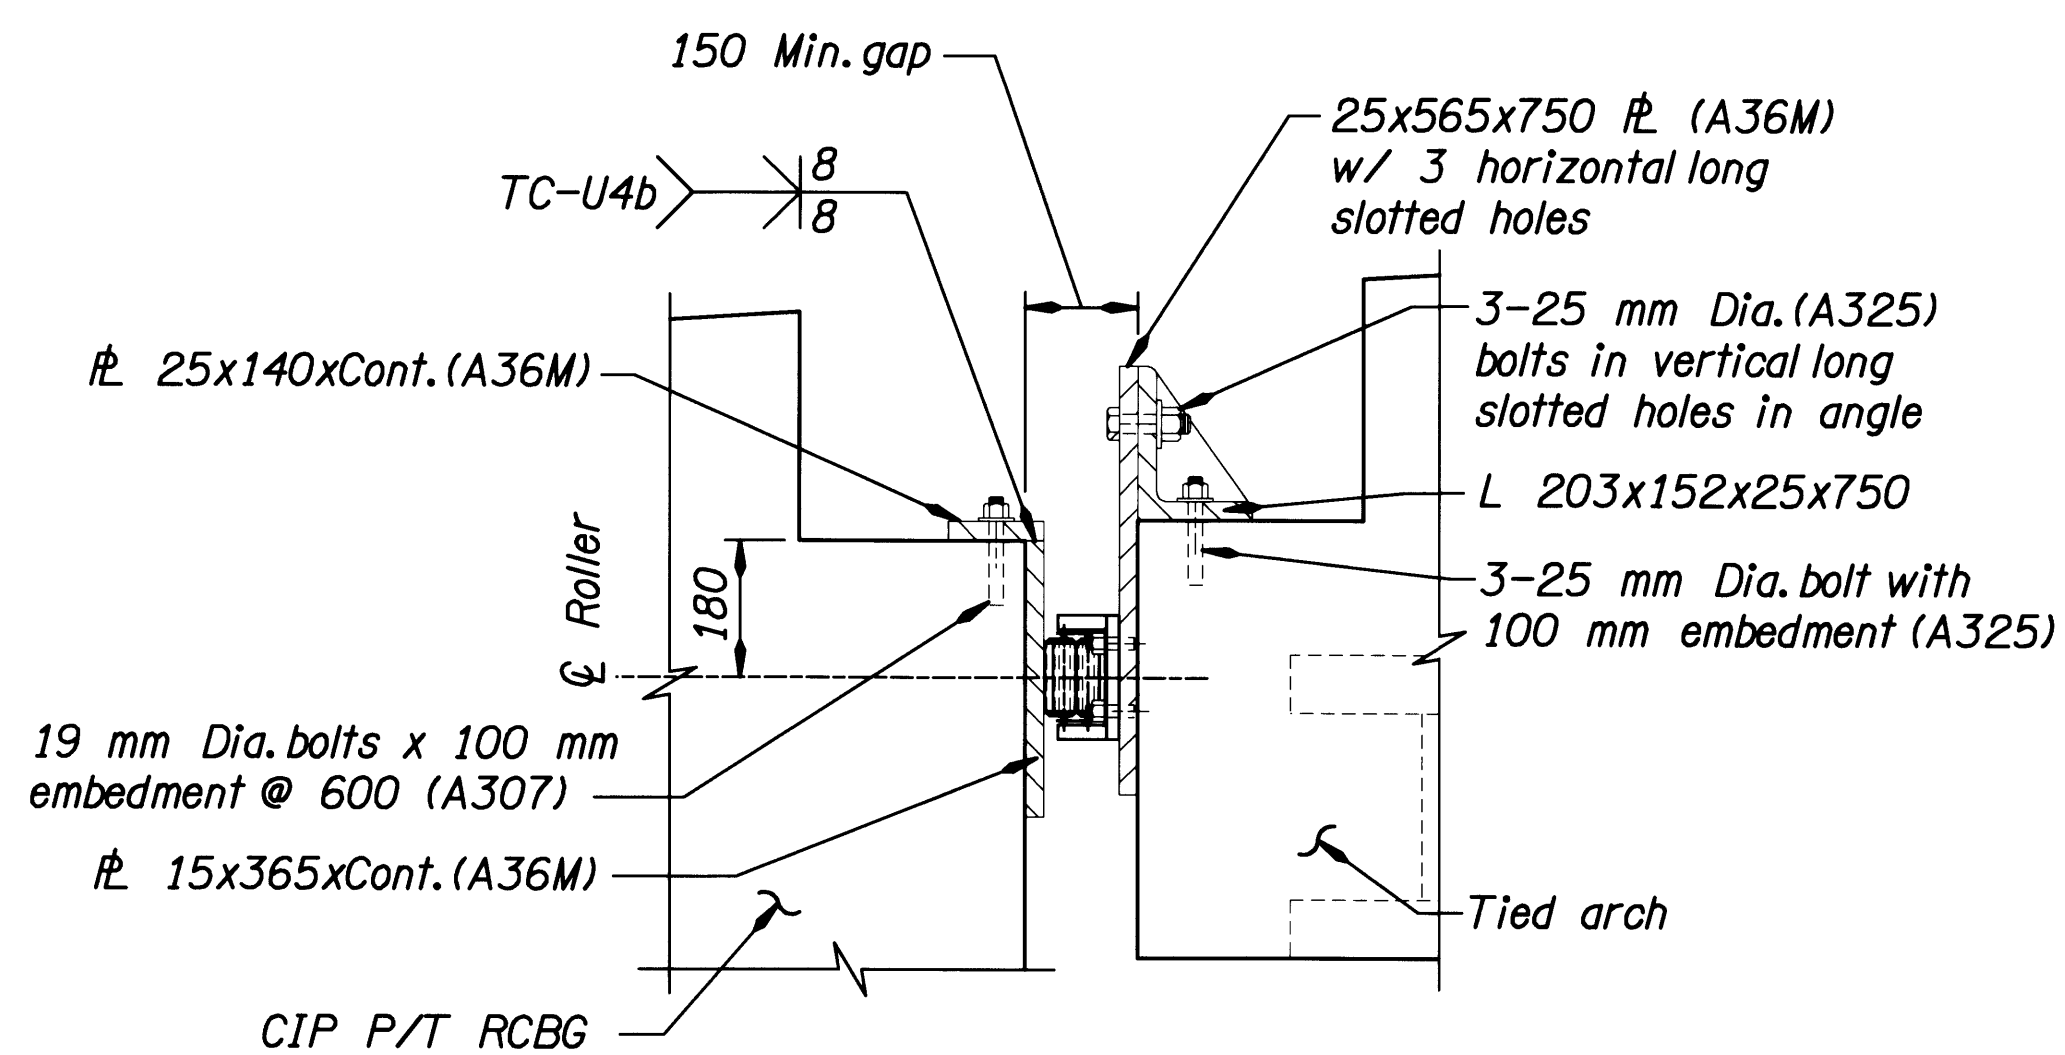

DETAIL "A"

Scale : 1:10

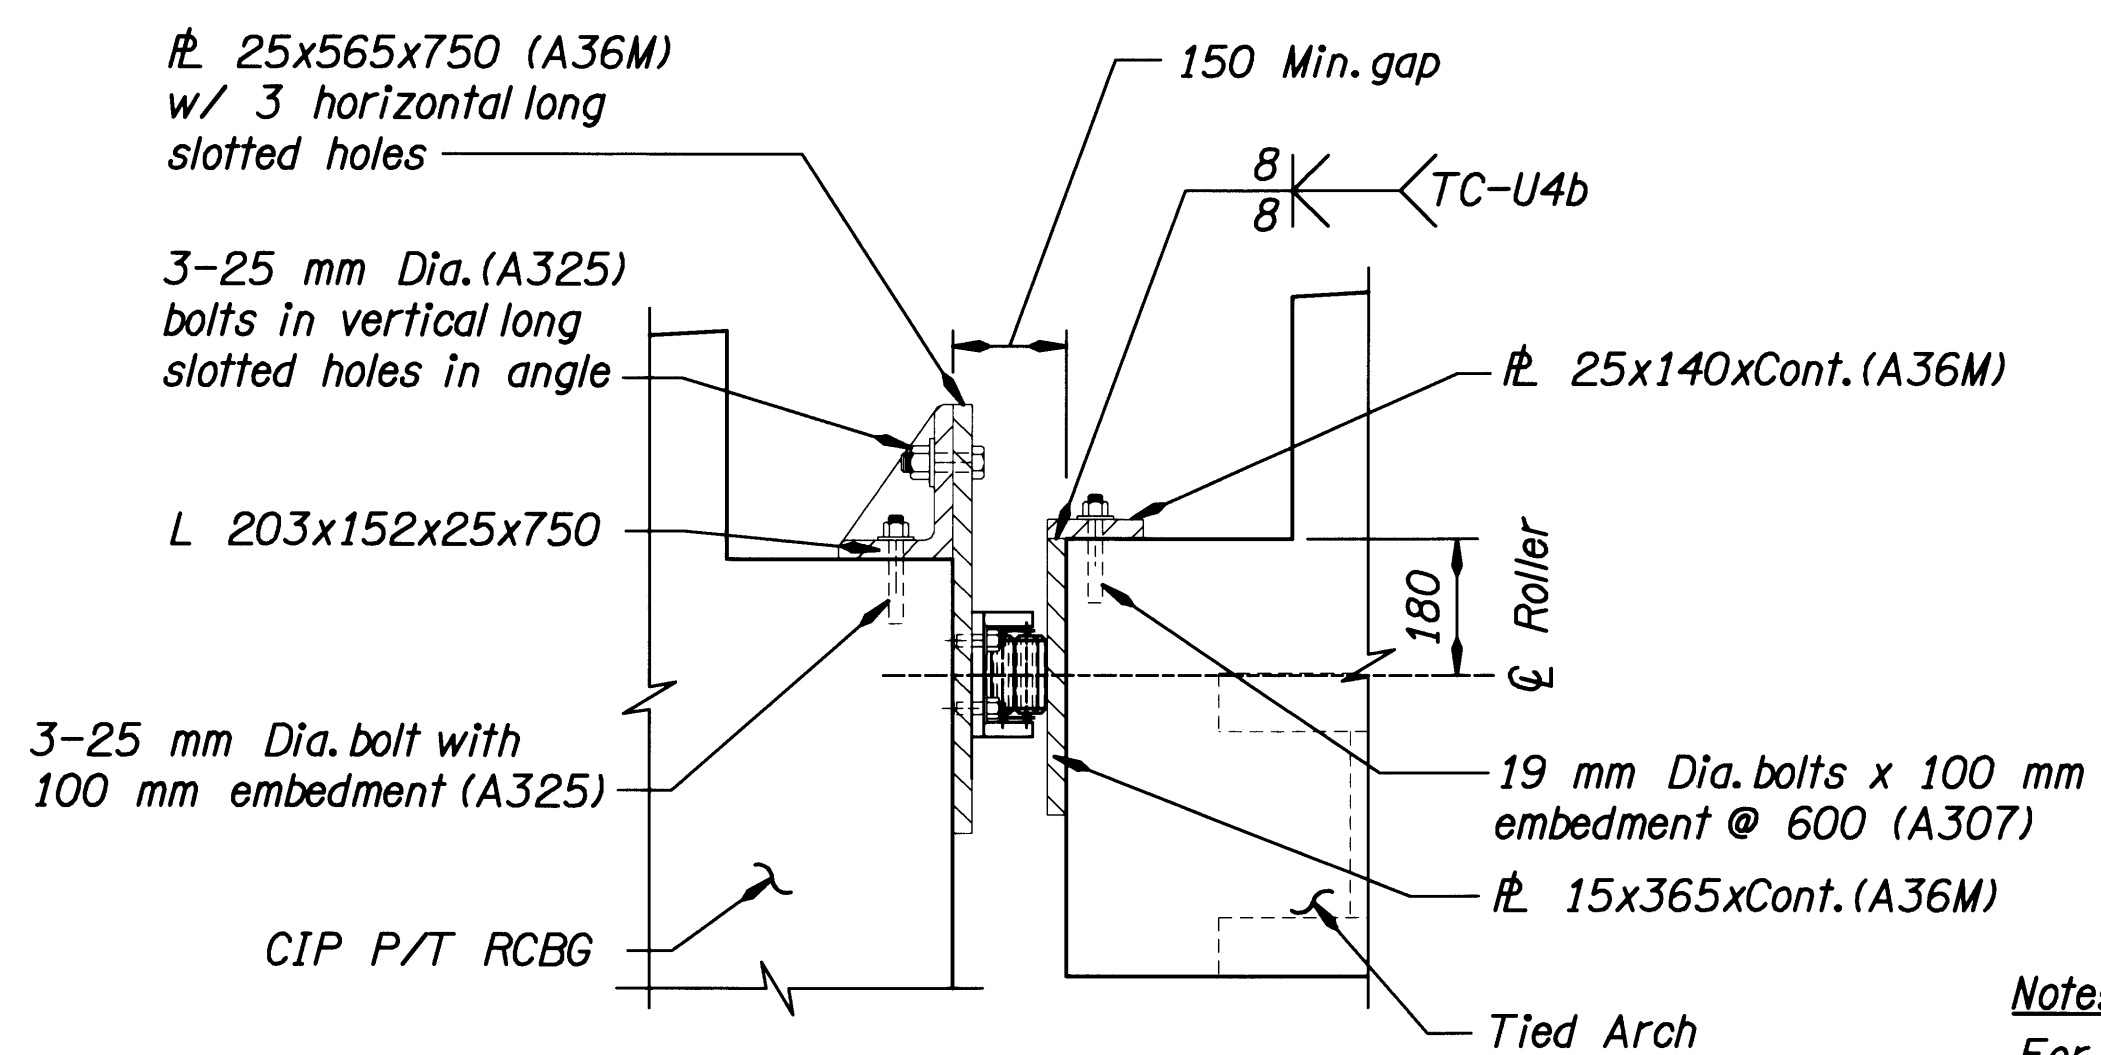

DETAIL "B"

Scale : 1:10


Note:
For plan view and roller details,
see Dwg #61785.

For Section "A-A" & "B-B" locations,
see Dwg #61785.





Note:
All dimensions are in millimeters (mm) and
all elevations are meters (m) except as noted.



	DATE	REVISION	BY	R. Elwood DRAFTED: CHECKED: <i>Kent Cordtz</i> Terry Shike REVIEWED:	DESIGNER DAVID EVANS AND ASSOCIATES INC. 530 Center Street N.E., Suite 605 Salem Oregon 97301 Phone: 503.361.8635 EXPIRES: 12-31-04	 OREGON DEPARTMENT OF TRANSPORTATION BRIDGE ENGINEERING SECTION	BRIDGE NO.	ROGUE RIVER (DEPOT STREET) BRIDGE	SHEET 68 OF 81
	03/08	AS CONSTRUCTED	AVS				19273		
							DATE		
							Nov. 2002		
							CALC. BOOK		
							5081	BENT 2 - VERTICAL ROLLER	DRAWING NO. 61786

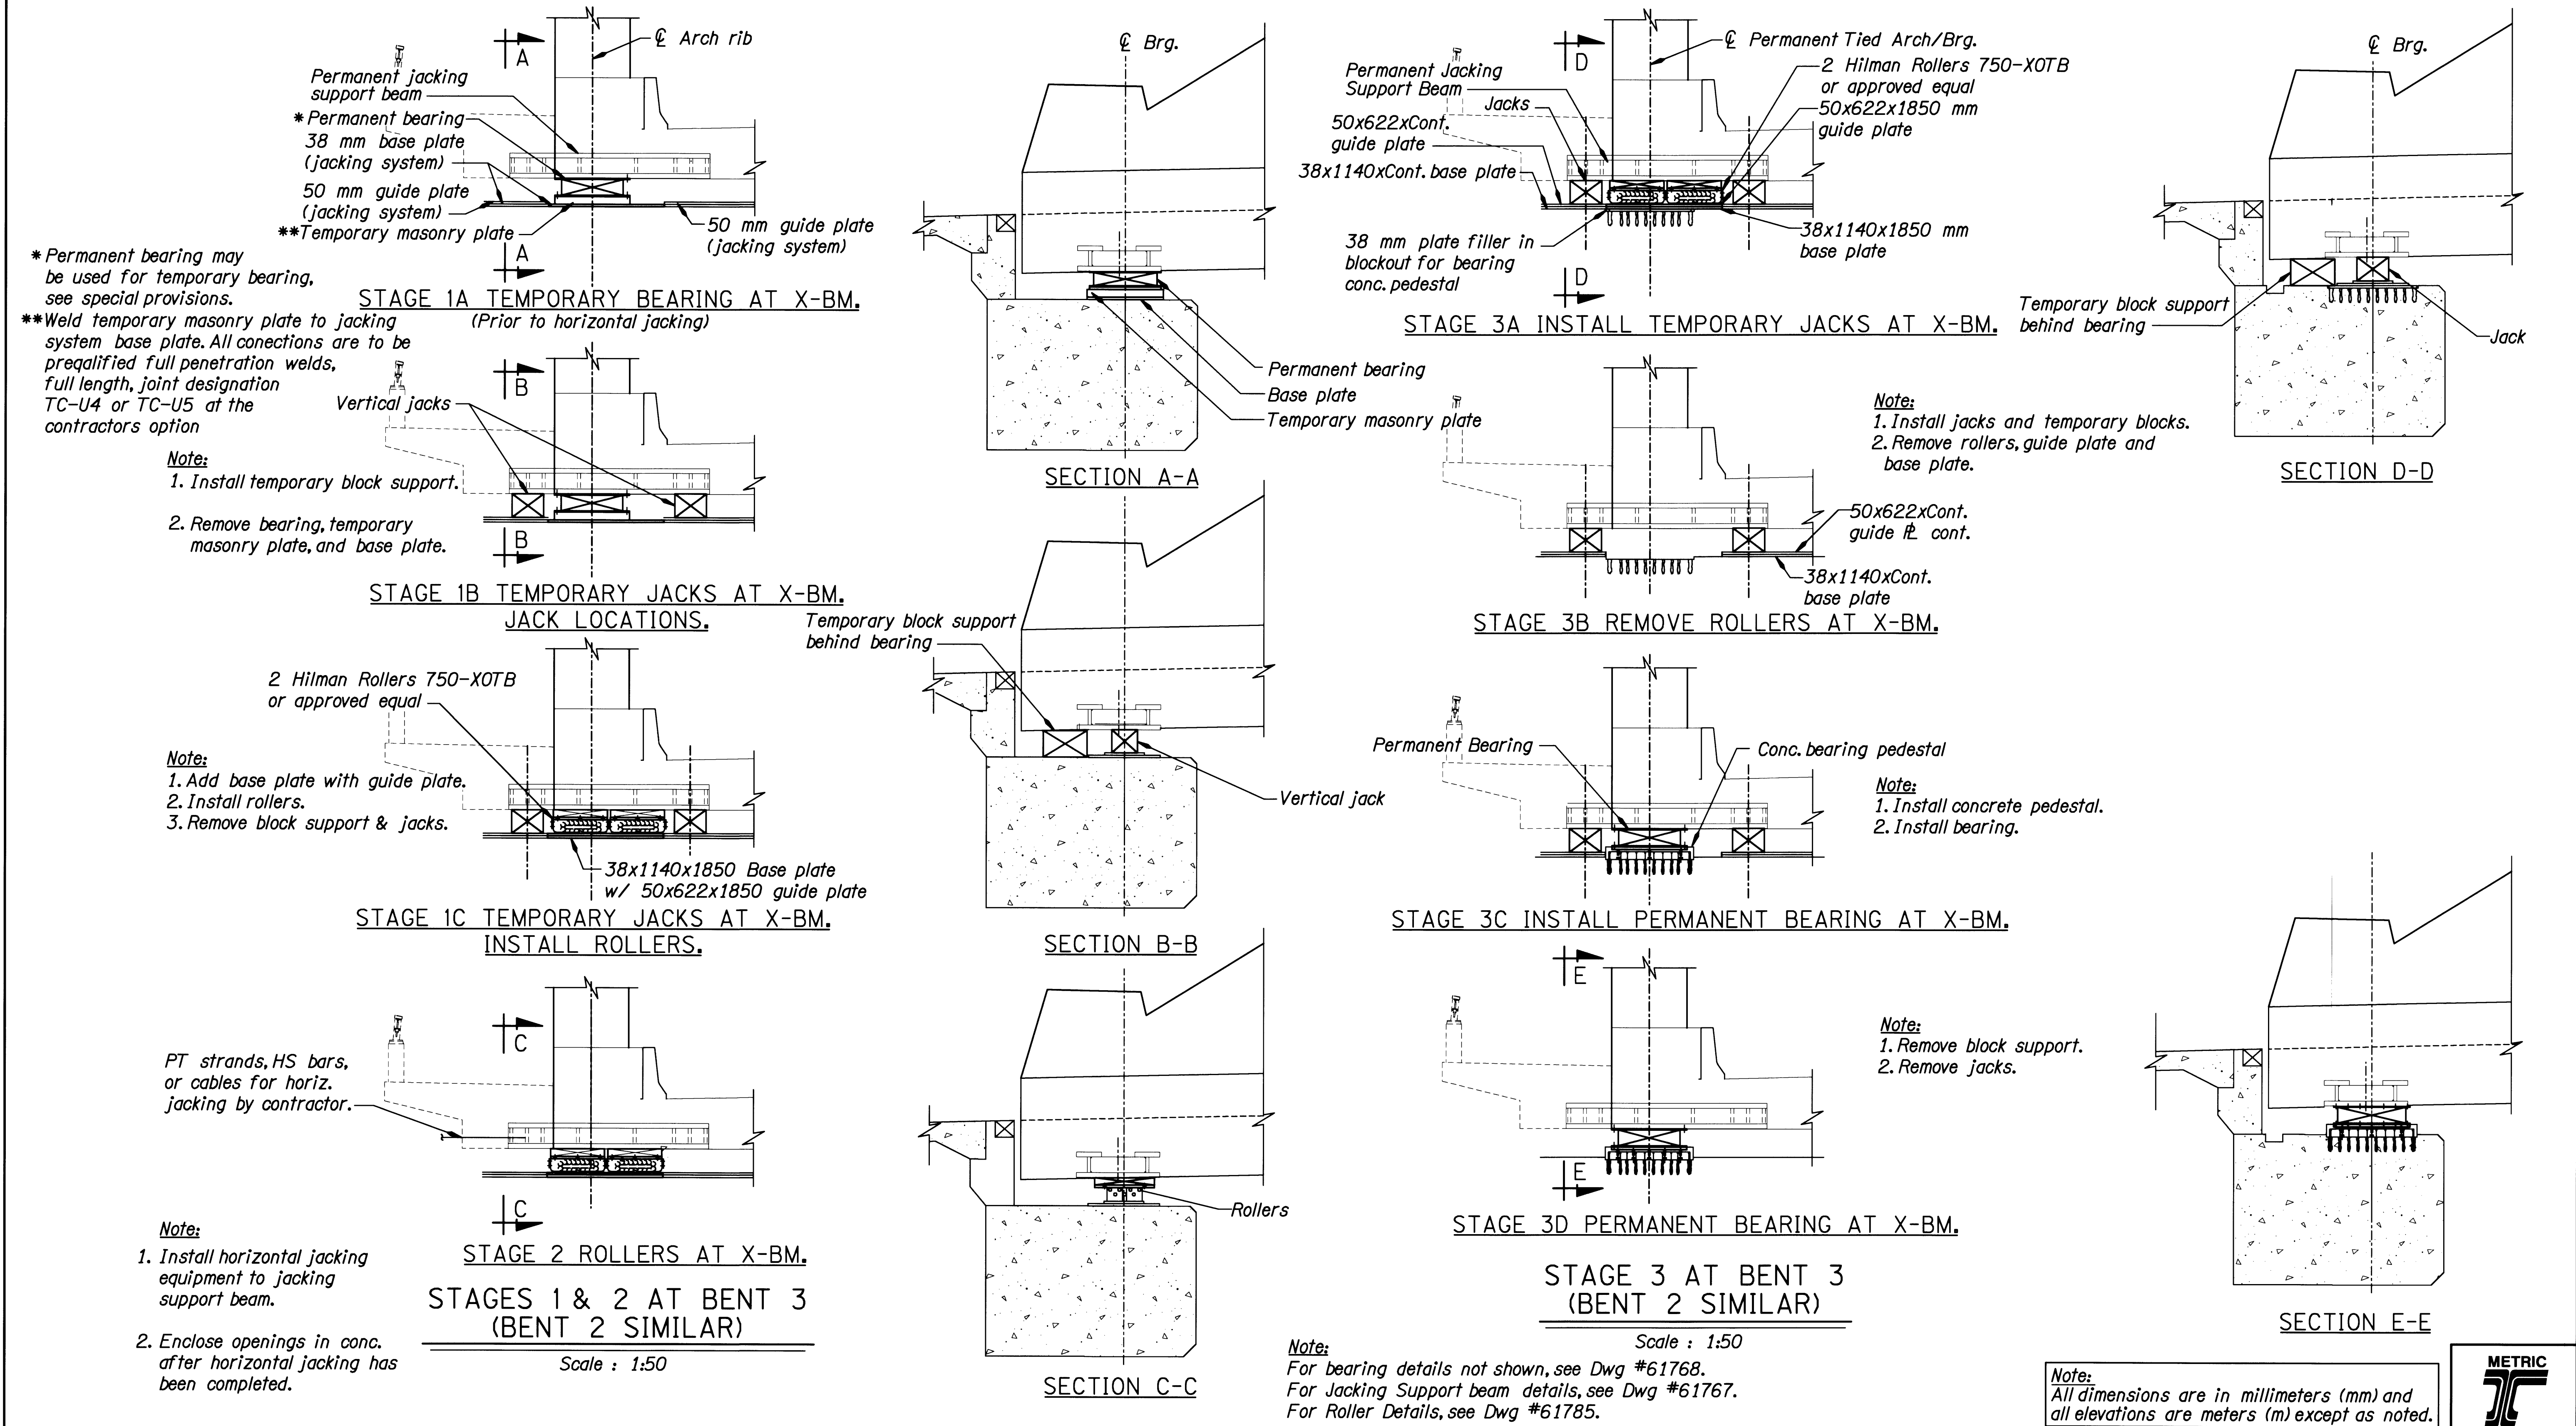

	DATE	REVISION	BY	C. Schreiner DRAFTED: CHECKED: <i>Kent Cordtz</i> REVIEWED: <i>Terry Shike</i>			BRIDGE NO.	ROGUE RIVER (DEPOT STREET) BRIDGE	SHEET 69 OF 81
	03/08	AS CONSTRUCTED					19273		
							DATE		
							Nov. 2002		
							CALC. BOOK	BEARING INSTALLATION SEQUENCE	DRAWING NO. 61787
							5081		

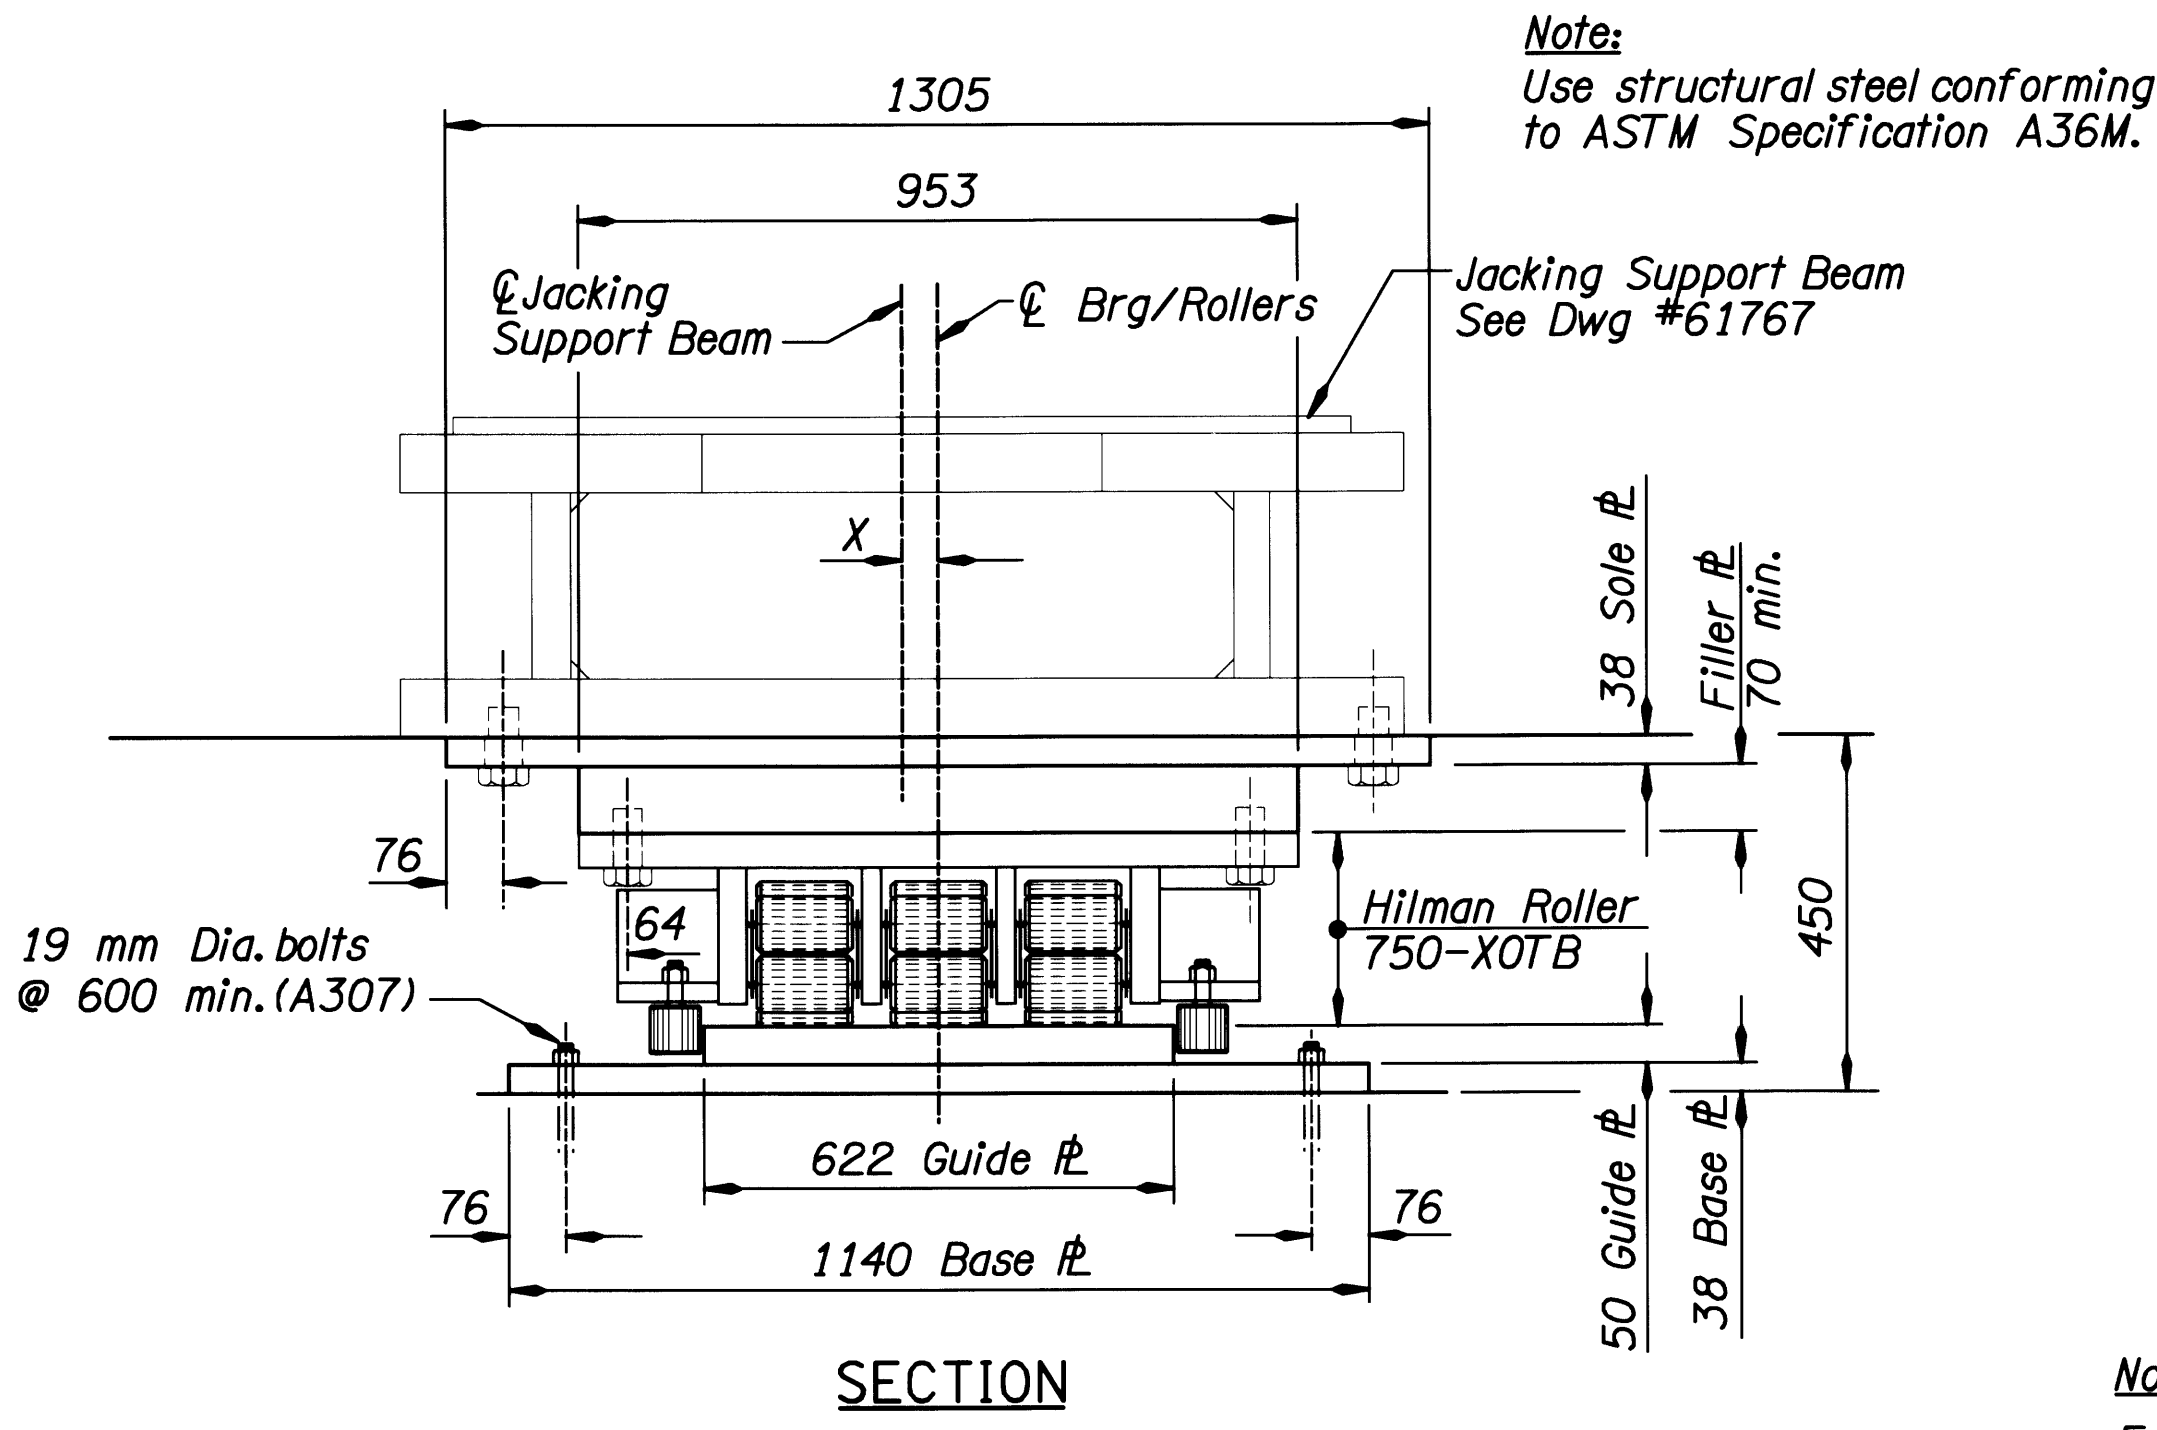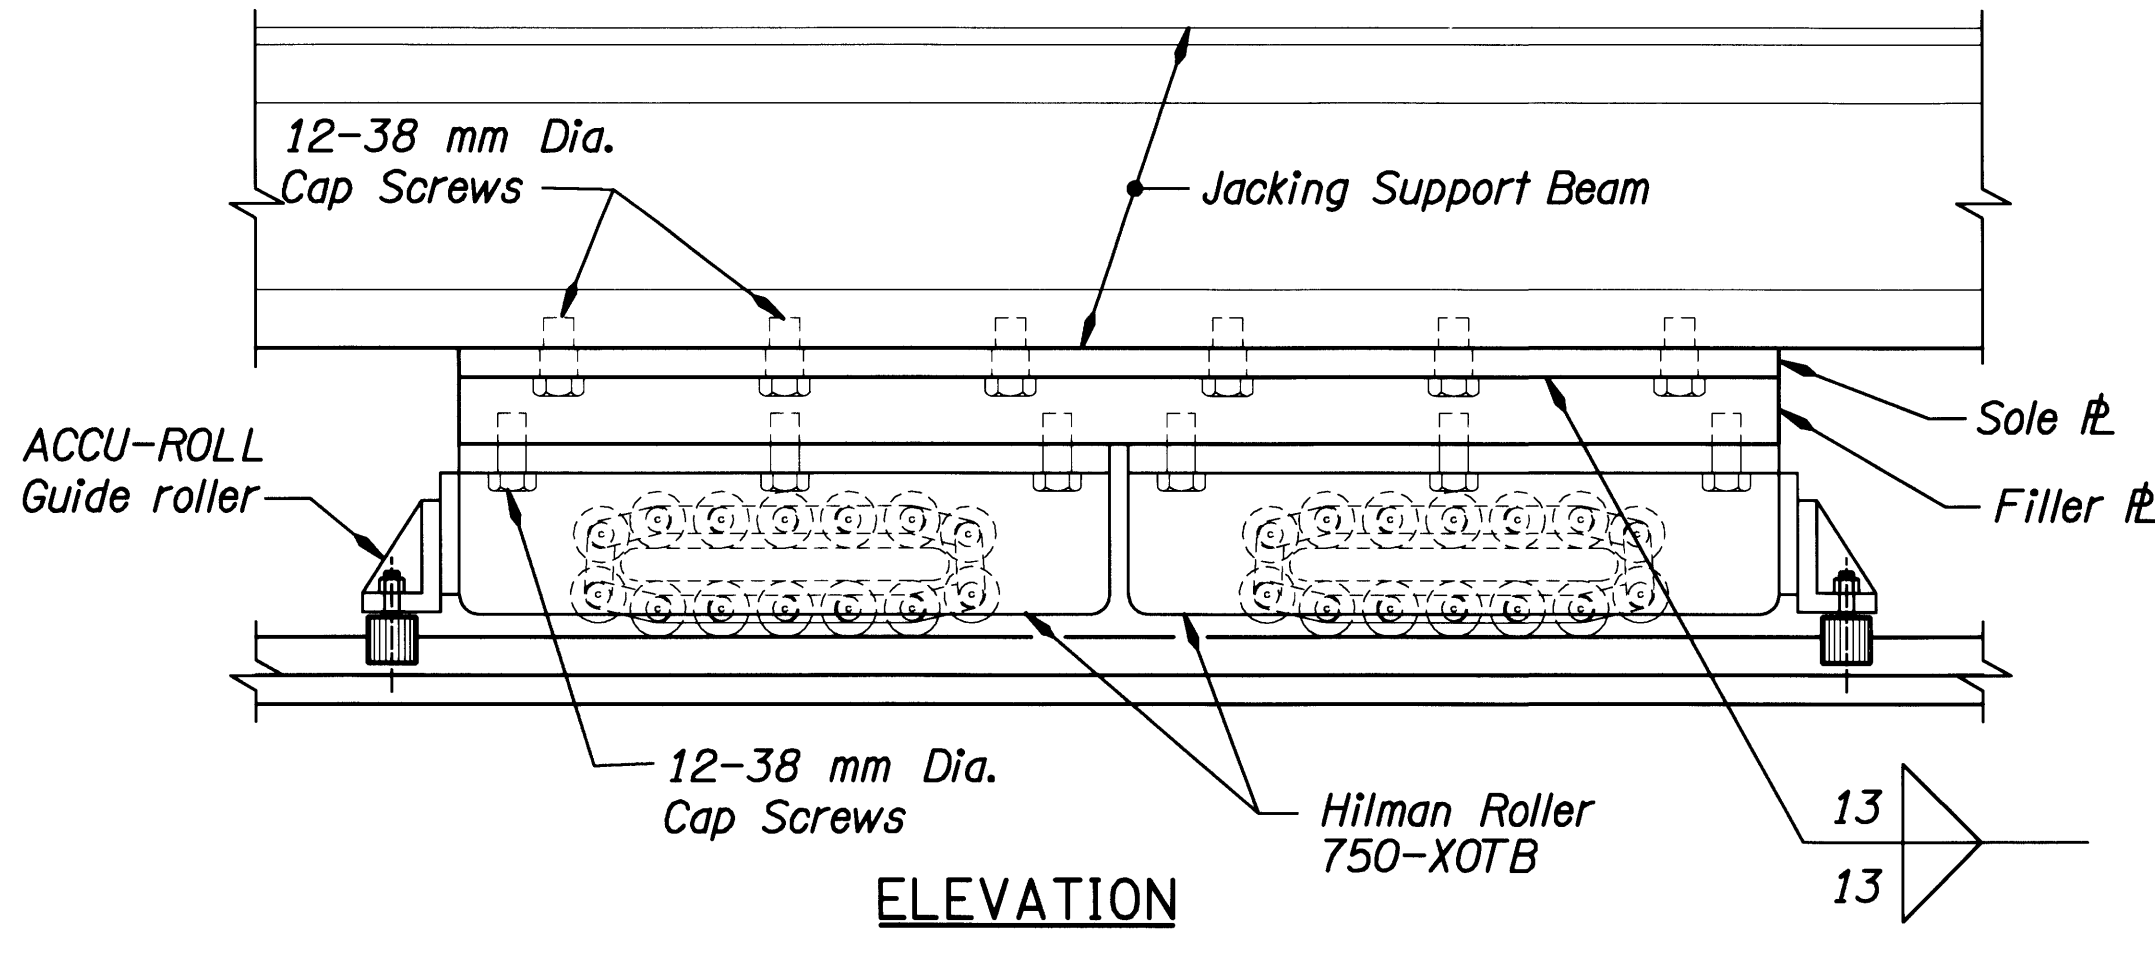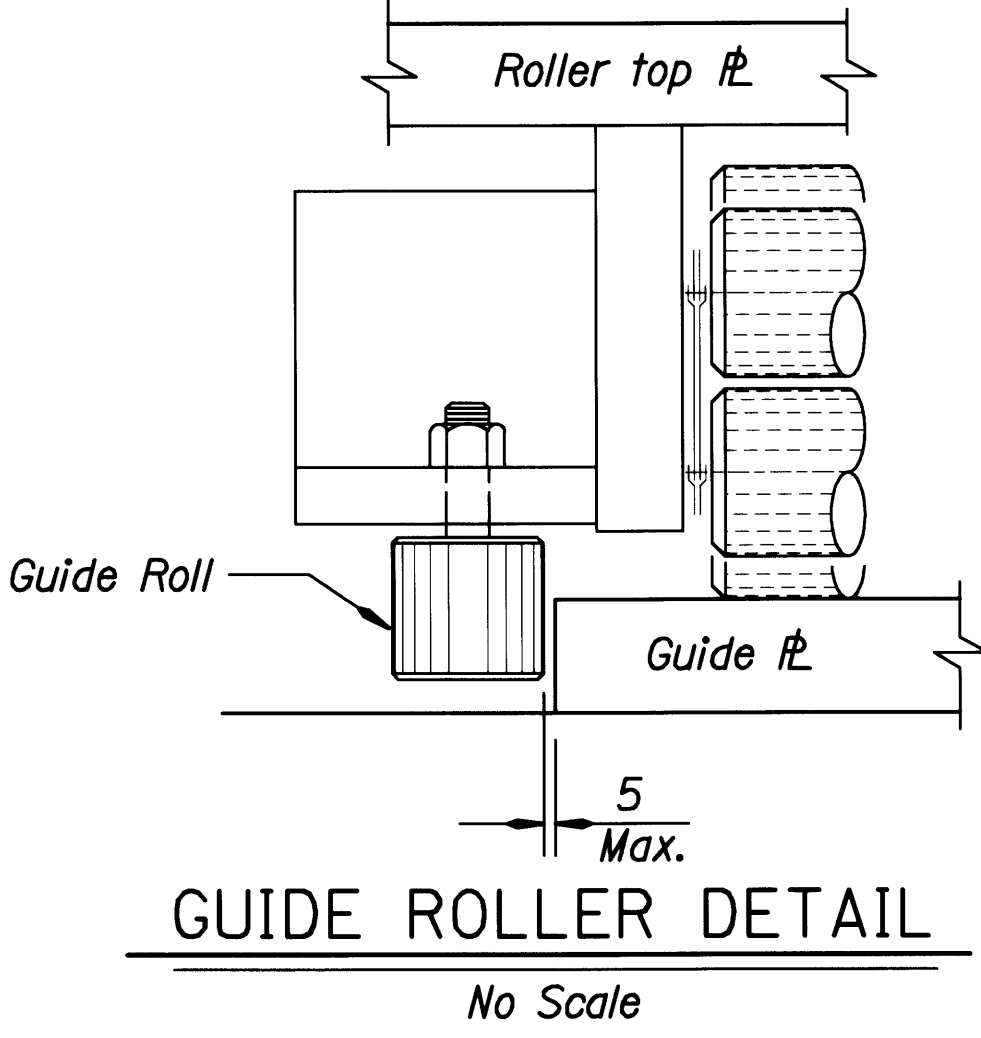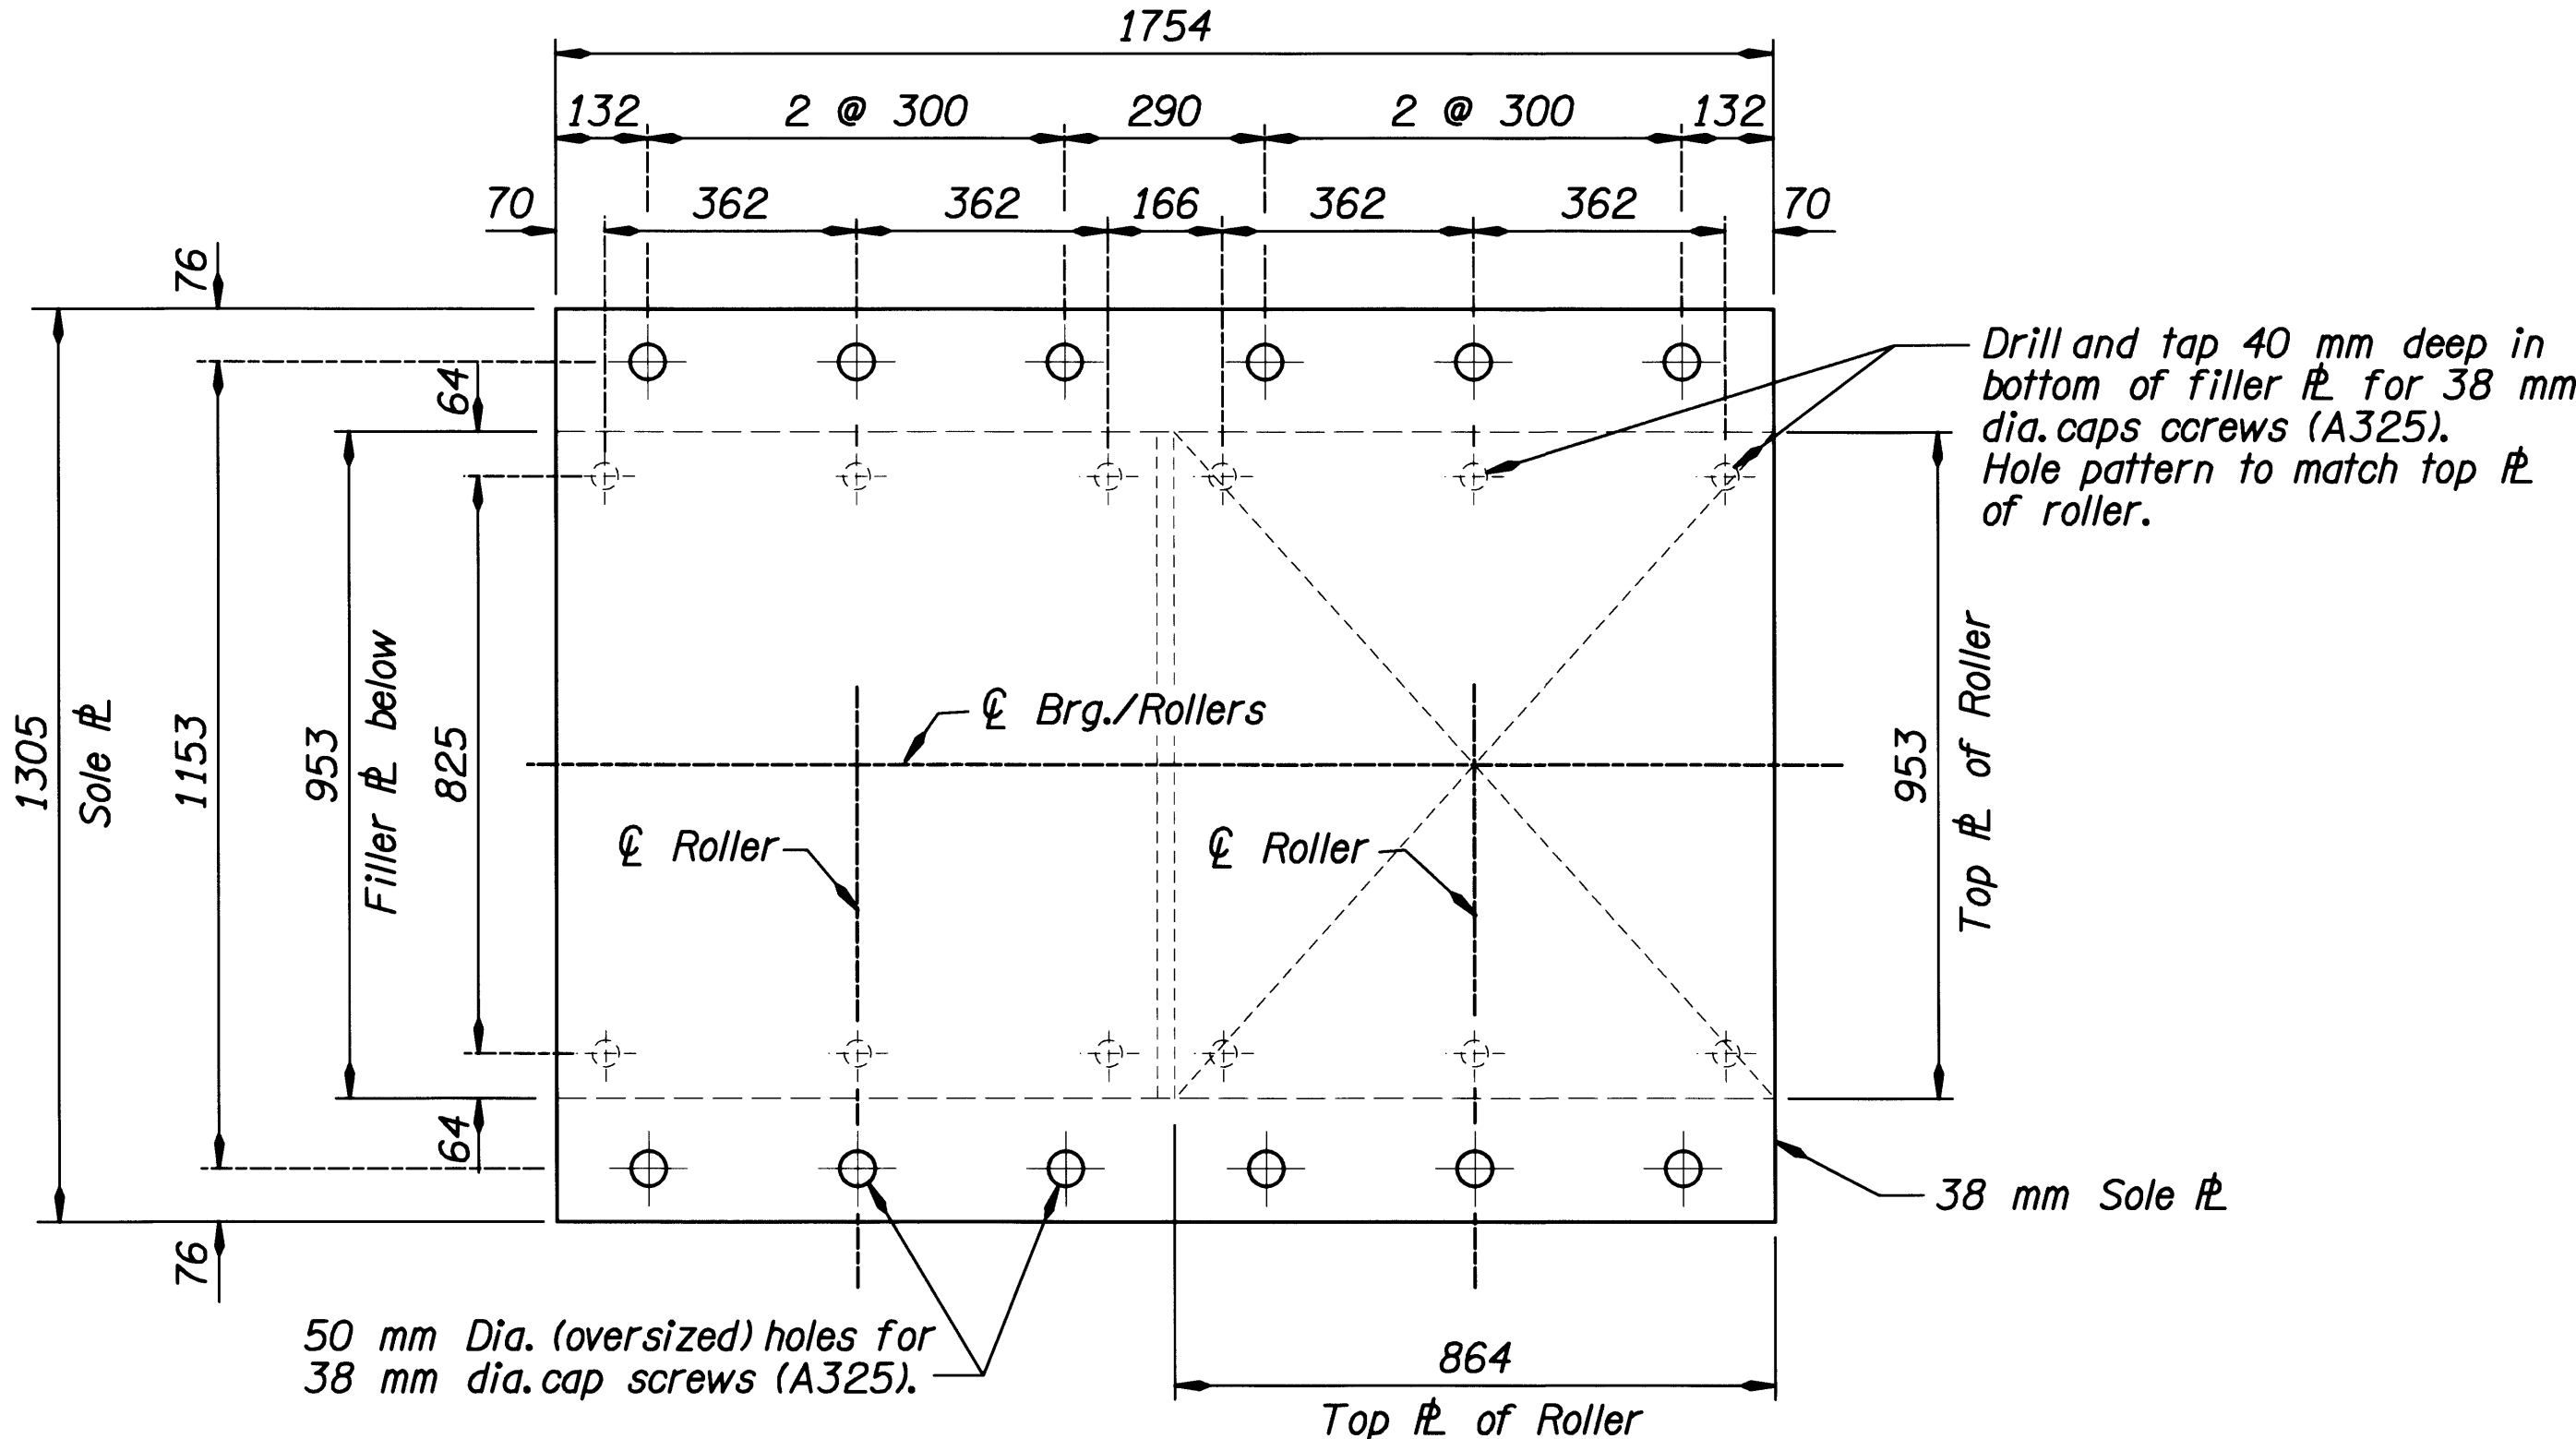

ROLLER DETAILS

Scale : 1:10

Note:
For Construction Staging Section, see Dwg #61726.
For Bearing Staging Sequence, see Dwg #61787.
For Jacking Support Beam, see Dwg #61767.
For initial offset (X), See Dwg. #61768.

Note:
All dimensions are in millimeters (mm) and all elevations are meters (m) except as noted.

	DATE	REVISION	BY	DESIGNER DAVID EVANS AND ASSOCIATES INC. 530 Center Street N.E., Suite 605 Salem Oregon 97301 Phone: 503.361.8635 EXPIRES: 12-31-04	 OREGON DEPARTMENT OF TRANSPORTATION BRIDGE ENGINEERING SECTION	BRIDGE NO.	ROGUE RIVER (DEPOT STREET) BRIDGE	SHEET 70 OF 81
	03/08	AS CONSTRUCTED	AVS			19273		
						DATE		
						Nov. 2002		
						CALC. BOOK	JACKING ROLLER DETAILS	DRAWING NO. 61788
						5081		